

STATE ENGINEER
Salem, Oregon

LINN 54213

Well Record

STATE WELL NO. 12/3W - 23G
COUNTY LINN
APPLICATION NO. GR-2213

OWNER: Dean Wheeler


MAILING ADDRESS: Rt. 1

LOCATION OF WELL: Owner's No.

CITY AND STATE: Tangent, Oregon

SW 1/4 NE 1/4 Sec. 23 T. 12 N. S. R. 3 E. W. M.

Bearing and distance from section or subdivision corner 1452' S. and 2838' E.

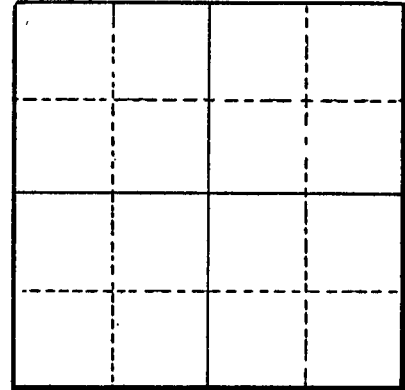

Altitude at well

TYPE OF WELL: Drilled Date Constructed 1949

Depth drilled 85 Depth cased 85

Section

CASING RECORD:

8-Inch

FINISH:

Perforations from 25 to 85

AQUIFERS:

WATER LEVEL:

22-Fest

PUMPING EQUIPMENT: Type Jacuzzi Jet H.P. 3
Capacity 50 G.P.M.

WELL TESTS:

Drawdown ft. after hours G.P.M.

Drawdown ft. after hours G.P.M.

USE OF WATER Irrigation Temp. °F. 19

SOURCE OF INFORMATION GR-2118

DRILLER or DIGGER Mr. Studebaker, Salem, Oregon

ADDITIONAL DATA:

Log Water Level Measurements Chemical Analysis Aquifer Test

REMARKS: