

STATE ENGINEER
Salem, Oregon

~~LINN~~
~~10587~~

LINN 54243
Well Record


STATE WELL NO. 12/3W-35M
COUNTY LINN
~~APPLICATION NO.~~ GR-2782

OWNER: Homer I. and Frances E. Webber MAILING ADDRESS: Route 1, Box 141
LOCATION OF WELL: Owner's No. #2 CITY AND STATE: Shedd, Oregon

NW 1/4 SW 1/4 Sec. 35 T. 12 N. S. R. 3 E. W., W.M.

Bearing and distance from section or subdivision

corner 1716' N. and 200' E.

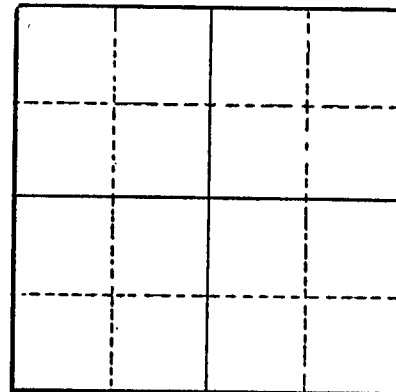

Section

Altitude at well

TYPE OF WELL: drilled Date Constructed 1952

Depth drilled 133 Depth cased 133

CASING RECORD:

8-inch

FINISH:

Slot perforations from 120 to 133

AQUIFERS:

WATER LEVEL:

120-feet

PUMPING EQUIPMENT: Type Jacuzzi Submersible H.P. 5
Capacity 100 G.P.M.

WELL TESTS:

Drawdown ft. after hours Pumping 100 G.P.M.

Drawdown ft. after hours G.P.M.

USE OF WATER irrigation Temp. °F., 19

SOURCE OF INFORMATION GR-2629

DRILLER or DIGGER Cy Burkhart

ADDITIONAL DATA:

Log Water Level Measurements Chemical Analysis Aquifer Test

REMARKS: