

STATE ENGINEER
Salem, Oregon

~~LINN~~ LINN 54244
~~10588~~ Well Record


STATE WELL NO. 12/3W-35N
COUNTY LINN
APPLICATION NO. GR-2783

OWNER: Homer L. and Frances E. Webber MAILING ADDRESS: Rt. 1, Box 141

LOCATION OF WELL: Owner's No. #1 CITY AND STATE: Shedd, Oregon

SW 1/4 SW 1/4 Sec. 35 T. 12 N. S., R. 3 E. W.M.

Bearing and distance from section or subdivision
corner 858' N. and 200' E.

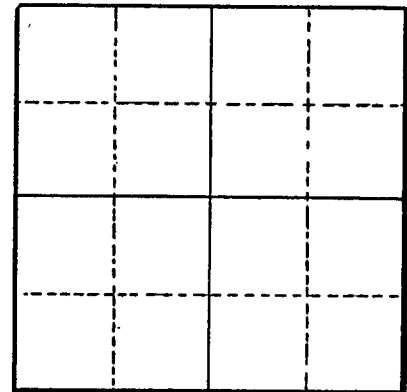

Section

Altitude at well

TYPE OF WELL: drilled Date Constructed 1949

Depth drilled 43 Depth cased 43

CASING RECORD:

8-inch

FINISH:

Slot perforations from 36 to 43

AQUIFERS:

WATER LEVEL:

36-feet

PUMPING EQUIPMENT: Type Jacuzzi Jet H.P. 3
Capacity 50 G.P.M.

WELL TESTS:

Drawdown 36 ft. after hours Pumping 50 G.P.M.

Drawdown ft. after hours G.P.M.

USE OF WATER irrigation Temp. °F. 19

SOURCE OF INFORMATION GR-2630

DRILLER or DIGGER Cy Burkhardt

ADDITIONAL DATA:

Log Water Level Measurements Chemical Analysis Aquifer Test

REMARKS: