

STATE ENGINEER  
Salem, Oregon


Linn  
5552

# Well Record

STATE WELL NO. 10/6-17E  
COUNTY LINN  
APPLICATION NO. GR-3481

OWNER: Simson Redwood Company dba Simson Logging Company  
MAILING ADDRESS: 2301 N. Columbia Blvd.,  
CITY AND STATE: Portland, Oregon

LOCATION OF WELL: Owner's No. \_\_\_\_\_  
SW 1/4 NW 1/4 Sec. 17 T. 10 S., R. 6 W., W.M.  
Bearing and distance from section or subdivision  
corner 1522' S. and 953' E.

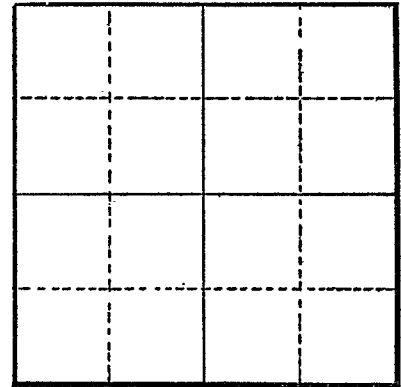

Section \_\_\_\_\_

Altitude at well \_\_\_\_\_

TYPE OF WELL: drilled Date Constructed 1954  
Depth drilled 106 Depth cased 103

### CASING RECORD:

8-inch

### FINISH:

### AQUIFERS:

gravel, sand and boulders

### WATER LEVEL:

14-feet

PUMPING EQUIPMENT: Type Pacific turbine H.P. 2  
Capacity 50 G.P.M.

### WELL TESTS:

Drawdown \_\_\_\_\_ ft. after \_\_\_\_\_ hours \_\_\_\_\_ G.P.M.  
Drawdown \_\_\_\_\_ ft. after \_\_\_\_\_ hours \_\_\_\_\_ G.P.M.

USE OF WATER domestic, industrial Temp. \_\_\_\_\_ °F. \_\_\_\_\_, 19

SOURCE OF INFORMATION GR-3215

DRILLER or DIGGER \_\_\_\_\_

### ADDITIONAL DATA:

Log  Water Level Measurements \_\_\_\_\_ Chemical Analysis \_\_\_\_\_ Aquifer Test \_\_\_\_\_

### REMARKS:

Boulder gravel and sand	24	24
muddy sand	38	62
boulders and sand	30	92
gravel, water bearing	14	106