

STATE ENGINEER
Salem, Oregon

Linn
5834


Well Record

STATE WELL NO. 11/1W-20L
COUNTY LINN
APPLICATION NO. GR-2460

OWNER: W. S. Sparks MAILING ADDRESS: Rt. 3, B., 116 C.

LOCATION OF WELL: Owner's No. _____ CITY AND STATE: Lebanon, Oregon

NE ¼ SW ¼ Sec. 20 T. 11 S., R. 1 W., W.M.
Bearing and distance from section or subdivision corner 1749' N. and 2640' W.

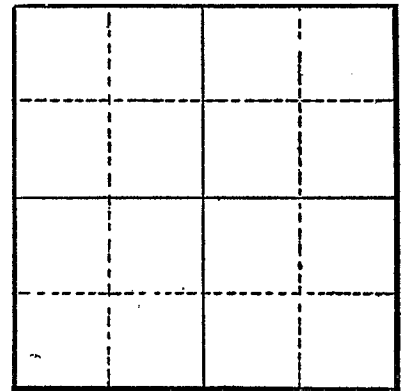

Section

Altitude at well

TYPE OF WELL: Drilled Date Constructed 1947

Depth drilled 115 Depth cased 80

CASING RECORD:

6-inch

FINISH:

AQUIFERS:

WATER LEVEL:
57-feet

PUMPING EQUIPMENT: Type Gould Jet H.P. 2
Capacity 25 G.P.M.

WELL TESTS:
Drawdown 70 ft. after _____ hours Pumping 80 G.P.M.
Drawdown _____ ft. after _____ hours _____ G.P.M.

USE OF WATER Irrigation Temp. _____ °F., 19

SOURCE OF INFORMATION GR-2331

DRILLER or DIGGER Rucker, Lebanon, Oregon

ADDITIONAL DATA:
Log _____ Water Level Measurements _____ Chemical Analysis _____ Aquifer Test _____

REMARKS: