

STATE OF OREGON
 WATER SUPPLY WELL REPORT
 (as required by ORS 537.765 & OAR 690-205-0210)

WELL LABEL # L 102068

START CARD # 205742

(1) LAND OWNER Owner Well I.D. 5091
 First Name _____ Last Name _____
 Company Flakeboard
 Address P.O. Box 428
 City Albany State OR Zip 97321

(2) TYPE OF WORK New Well Deepening Conversion
 Alteration (repair/recondition) Abandonment

(3) DRILL METHOD
 Rotary Air Rotary Mud Cable Auger Cable Mud
 Reverse Rotary Other _____

(4) PROPOSED USE Domestic Irrigation Community
 Industrial/ Commercial Livestock Dewatering
 Thermal Injection Other _____

(5) BORE HOLE CONSTRUCTION Special Standard Attach copy
 Depth of Completed Well 345 ft.

BORE HOLE			SEAL		sacks/		
Dia	From	To	Material	From	To	Amt	lbs
10	0	60	Cement	1	60	14	S
6	60	345	Bentonite	0	1	1	S

How was seal placed: Method A B C D E
 Other Poured dry
 Backfill placed from _____ ft. to _____ ft. Material _____
 Filter pack from _____ ft. to _____ ft. Material _____ Size _____
 Explosives used: Yes Type _____ Amount _____

(6) CASING/LINER
 Casing Liner Dia + From To Gauge Stl Plstc Wld Thrd

<input checked="" type="checkbox"/>	<input type="checkbox"/>	6	<input checked="" type="checkbox"/>	1	60	250	<input checked="" type="checkbox"/>	<input type="checkbox"/>	<input checked="" type="checkbox"/>	
-------------------------------------	--------------------------	---	-------------------------------------	---	----	-----	-------------------------------------	--------------------------	-------------------------------------	--

 Shoe Inside Outside Other Location of shoe(s) _____
 Temp casing Yes Dia 10 From 0 To 40

(7) PERFORATIONS/SCREENS
 Perforations Method Drilled
 Screens Type _____ Material _____

Perf/S	Casing/Screen	Liner	Dia	From	To	Scrm/slot width	Slot length	# of slots	Tele/pipe size
				165	345	25		6,000	

(8) WELL TESTS: Minimum testing time is 1 hour
 Pump Bailer Air Flowing Artesian

Yield gal/min	Drawdown	Drill stem/Pump depth	Duration (hr)
70		345	1

 Temperature 54 °F Lab analysis Yes By _____
 Water quality concerns? Yes (describe below)

From	To	Description	Amount	Units

(9) LOCATION OF WELL (legal description)
 County LINN Twp 10 S N/S Range 3 W E/W WM
 Sec 33 NW 1/4 of the NE 1/4 Tax Lot 151
 Tax Map Number _____ Lot _____
 Lat _____ " or 0 DMS or DD
 Long _____ " or _____ DMS or DD
 Street address of well Nearest address

2550 NE Old Salem Rd., Albany, OR 97321

(10) STATIC WATER LEVEL
 Date _____ SWL(psi) + SWL(ft)
 Existing Well / Predeepening _____
 Completed Well 05-20-2010 _____ 9
 Flowing Artesian? Dry Hole?

WATER BEARING ZONES Depth water was first found 130

SWL Date	From	To	Est Flow	SWL(psi)	+ SWL(ft)
05-20-2010	130	265	70		9

(11) WELL LOG Ground Elevation _____

Material	From	To
Gravel fill	0	10
Brown clay w/some gravel	10	20
Brown clay	20	25
Blue grey sandstone	25	245
Grey brown claystone	245	250
Black basalt	250	265
Grey sandstone	265	345

RECEIVED
 JUN 10 2010
 WATER RESOURCES DEPT
 JONES DRILLING CO., INC.
 SALEM, OREGON
 29400 SANTIAM HWY.
 LEBANON, OR 97355
 541-367-2560 541-451-2686
 1-800-915-8388

Date Started 05-17-2010 Completed 05-20-2010

(unbonded) Water Well Constructor Certification
 I certify that the work I performed on the construction, deepening, alteration, or abandonment of this well is in compliance with Oregon water supply well construction standards. Materials used and information reported above are true to the best of my knowledge and belief.

License Number 1411 Date 05-27-2010
 Password: (if filing electronically)
 Signed KAD


(bonded) Water Well Constructor Certification
 I accept responsibility for the construction, deepening, alteration, or abandonment work performed on this well during the construction dates reported above. All work performed during this time is in compliance with Oregon water supply well construction standards. This report is true to the best of my knowledge and belief.

License Number 1684 Date 05-27-2010
 Password: (if filing electronically)
 Signed Bygones
 Contact Info (optional) onesdrilling@hotmail.com

OWRD Basic Web Mapping Application (beta)

Latitude: 44.664348 , Longitude: -123.064
Oregon Lambert Coordinate: 645455.97, 10

- OWRD Data
- Base Data
- Imagery

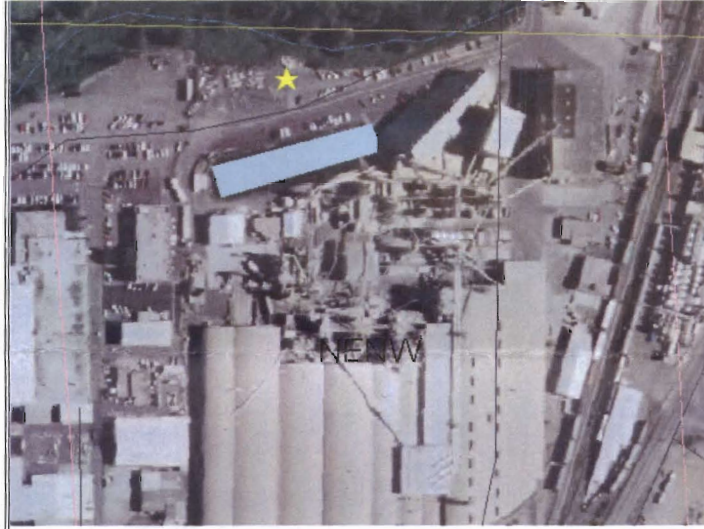

TRSQQ: 10.00S-03.00W-33-NENW


County: Linn
 Basin: Willamette
 WM District: 2
 WM Region: NW
 Withdrawn Area:
 WAB: [WILLAMETTE R > COLUMBIA R - / 14191000 \(183\)](#)
 Priority WAB:
 Rule 4D: Rules apply
 Groundwater
 Restricted:
 Scenic Water Way:
 Division 33: LOWER COLUMBIA
 Water Quality Limited: Yes
 Water Rights: [See Water Rights in this section \(](#)
 Well Logs: [See Well Logs in this section](#)

RECEIVED

AUG 11 2010

**WATER RESOURCES DEPT
SALEM, OREGON**

LAND OWNER SUBMITTED MAP

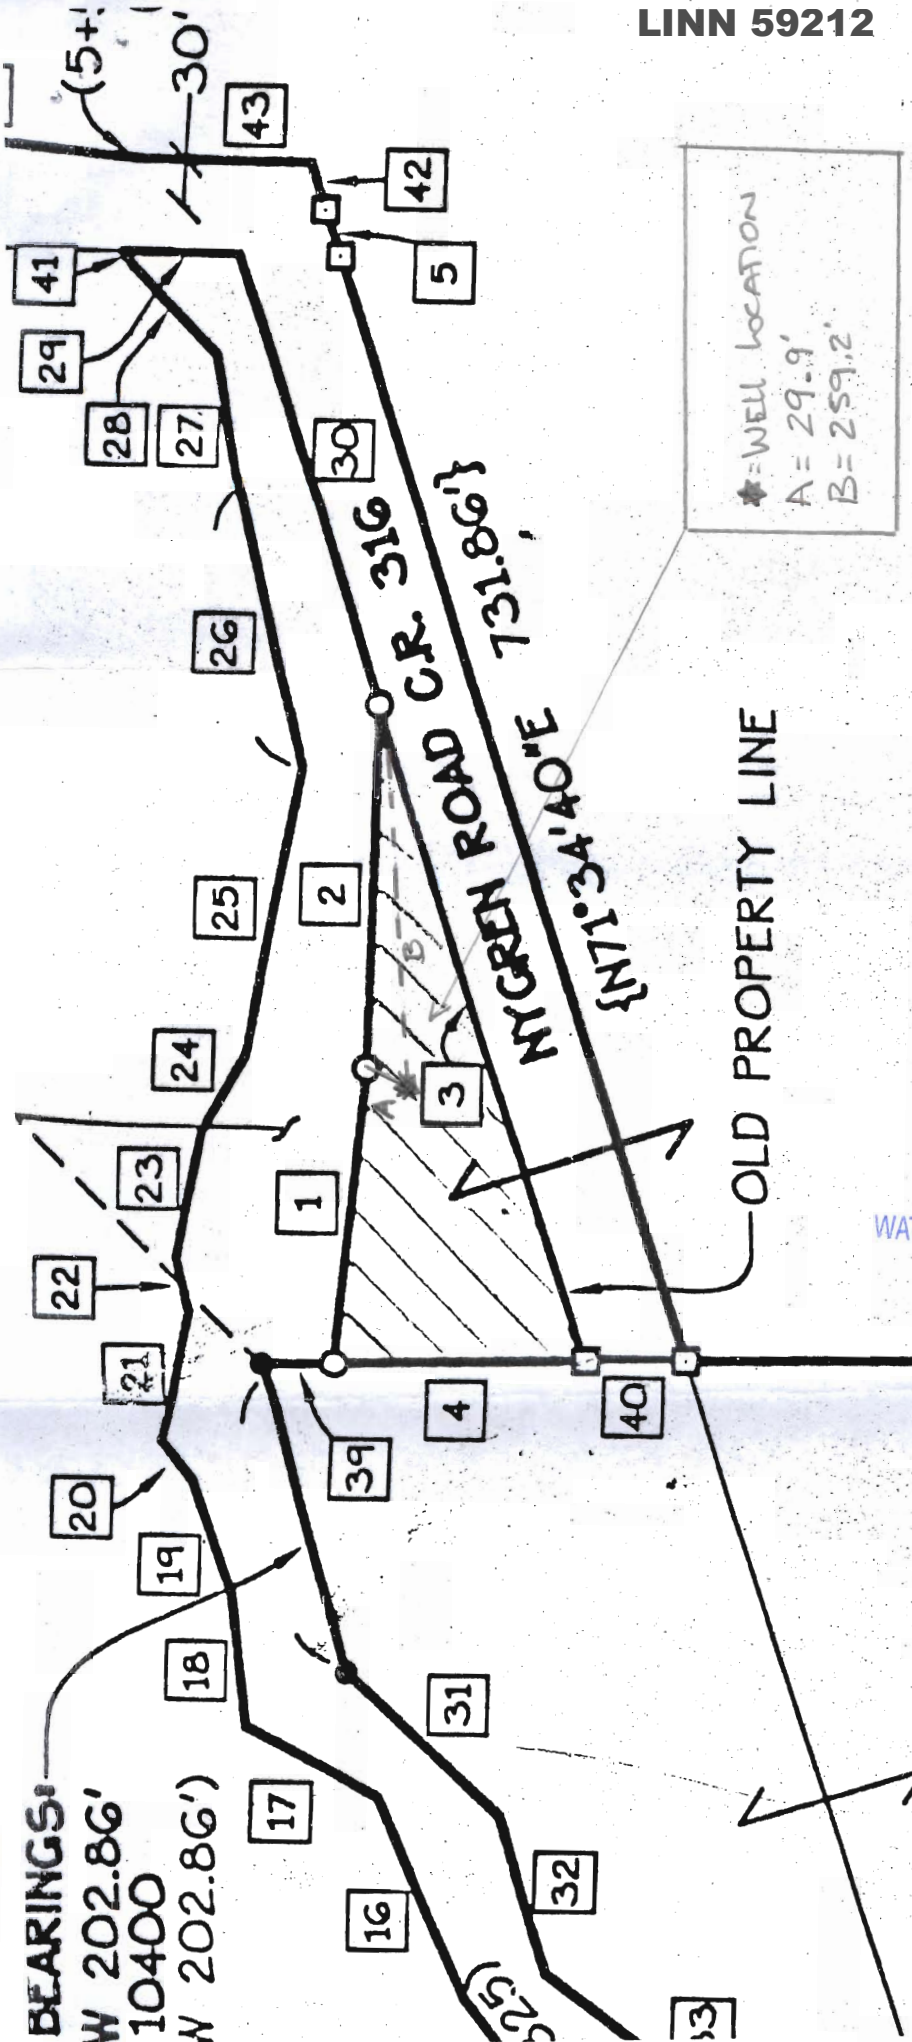

RECEIVED
 AUG 11 2010
 WATER RESOURCES DEPT
 SALEM, OREGON
 LAND OWNER SUBMITTED MAP

PROPERTY "A"

(WEYERHAEUSER TRACT PER MF 1586-311)

ORIGINAL AREA	22.45 ACRES
ADJUSTMENT	+0.72 ACRES
NEW AREA	23.17 ACRES

1 CHANG TRACT
 20K 343, PAGE 859)

{N1°10'00"E 882.66'}