

STATE ENGINEER  
Salem, Oregon

Linn  
~~###~~  
60815  
LINN 60815  
Well Record


STATE WELL NO. 10/2W-14B(1)  
COUNTY Linn  
APPLICATION NO. GR-829

OWNER: Mary Ammon  
MAILING ADDRESS: Rt. 2, Box 433

LOCATION OF WELL: Owner's No. \_\_\_\_\_  
CITY AND STATE: Albany, Oregon

NW 1/4 NE 1/4 Sec. 14 T. 10 N. S. R. 2 E. W., W.M.

Bearing and distance from section or subdivision  
corner S. 5° 45' E. 15.5 chs. from NW 1/4 of Sec. 14

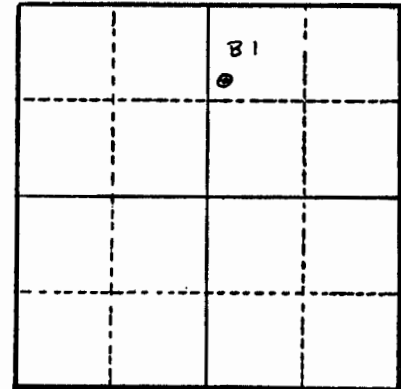

Section 14

Altitude at well 220 ft.

TYPE OF WELL: drilled Date Constructed \_\_\_\_\_

Depth drilled 35 ft. Depth cased 35 ft.

CASING RECORD: 10" steel 0 to 35 ft.

FINISH: Slot perforations 27 to 35 ft.

AQUIFERS:

WATER LEVEL: 14 ft.

PUMPING EQUIPMENT: Type Gardner-Denver 3" centrifugal H.P. 15 elec.  
Capacity 350 G.P.M.

WELL TESTS:  
Drawdown 4 ft. after \_\_\_\_\_ hours 350 G.P.M.  
Drawdown \_\_\_\_\_ ft. after \_\_\_\_\_ hours \_\_\_\_\_ G.P.M.

USE OF WATER irrigation Temp. \_\_\_\_\_ °F. \_\_\_\_\_, 19

SOURCE OF INFORMATION owner

DRILLER or DIGGER Fred Wymore; Salem, Oregon

ADDITIONAL DATA:

Log \_\_\_\_\_ Water Level Measurements \_\_\_\_\_ Chemical Analysis \_\_\_\_\_ Aquifer Test \_\_\_\_\_

REMARKS: