

Revised

STATE OF OREGON
GEOTECHNICAL HOLE REPORT
(as required by OAR 690-240-0035)

(1) OWNER/PROJECT Hole Number #2

PROJECT NAME/NBR:

First Name Last Name

Company Jackass Mountain Holding LLC

Address 660 Dogwood Rd.

City Pasco State WA Zip 99301

(2) TYPE OF WORK [X] New [] Deepening [X] Abandonment [] Alteration (repair/recondition)

(3) CONSTRUCTION

[X] Rotary Air [] Hand Auger [] Hollow stem auger
[] Rotary Mud [] Cable [] Push Probe
[] Other

(4) TYPE OF HOLE:

[X] Uncased Temporary [] Cased Permanent
[] Uncased Permanent [] Slope Stability
[] Other
Other: 6" casing installed and removed

(5) USE OF HOLE

Formation exploratory

(6) BORE HOLE CONSTRUCTION Special Standard [] Attach copy

Depth of Completed Hole 37.00 ft.

Table with columns: Dia, From, To, Material, SEAL From, To, Amt, sacks/lbs

Backfill placed from ft. to ft. Material
Filter pack from ft. to ft. Material Size

(7) CASING/SCREEN

Table with columns: Casing, Screen, Dia, From, To, Gauge, Stl, Plstc, Wld, Thrd

(8) WELL TESTS

[] Pump [] Bailer [X] Air [] Flowing Artesian
Yield gal/min Drawdown Drill stem/Pump depth Duration(hr)

Temperature 56 °F Lab analysis [] Yes By

Supervising Geologist/Engineer

Water quality concerns? [] Yes (describe below)

Table with columns: From, To, Description, Amount, Units

(9) LOCATION OF HOLE (legal description)

County LINN Twp 10.00 S N/S Range 3.00 W E/W WM

Sec 20 SE 1/4 of the NW 1/4 Tax Lot 300

Tax Map Number Lot

Lat " or DMS or DD

Long " or DMS or DD

[X] Street address of hole [] Nearest address

Conser Rd. & Woods Rd. - Millersburg, OR

(10) STATIC WATER LEVEL

Table with columns: Existing Well / Predeepening, Date, SWL(psi), SWL(ft)

Flowing Artesian? []
WATER BEARING ZONES Depth water was first found 17.00

Table with columns: SWL Date, From, To, Est Flow, SWL(psi), SWL(ft)

(11) SUBSURFACE LOG Ground Elevation

Table with columns: Material, From, To

Date Started 08-28-2017 Completed 08-28-2017

(12) ABANDONMENT LOG:

Table with columns: Material, From, To, Amt, sacks/lbs

Date Started 08-28-2017 Completed 08-28-2017

Professional Certification (to be signed by an Oregon licensed water or monitoring well constructor, Oregon registered geologist or professional engineer).

I accept responsibility for the construction, deepening, alteration, or abandonment work performed during the construction dates reported above. All work performed during this time is in compliance with Oregon geotechnical hole construction standards. This report is true to the best of my knowledge and belief.

License/Registration Number 1888 Date 10/02/17

First Name Kenneth Last Name Gillett

Affiliation Jones Drilling Co., Inc.


THIS MAP WAS PREPARED FOR ASSESSMENT PURPOSES ONLY

LINN 62065
SEC. 20 T. 10S. R. 03W. W.M.
LINN COUNTY, OREGON

1" = 400'

SEE MAP 10-3W-17

10 3W 20
MILLERSBURG

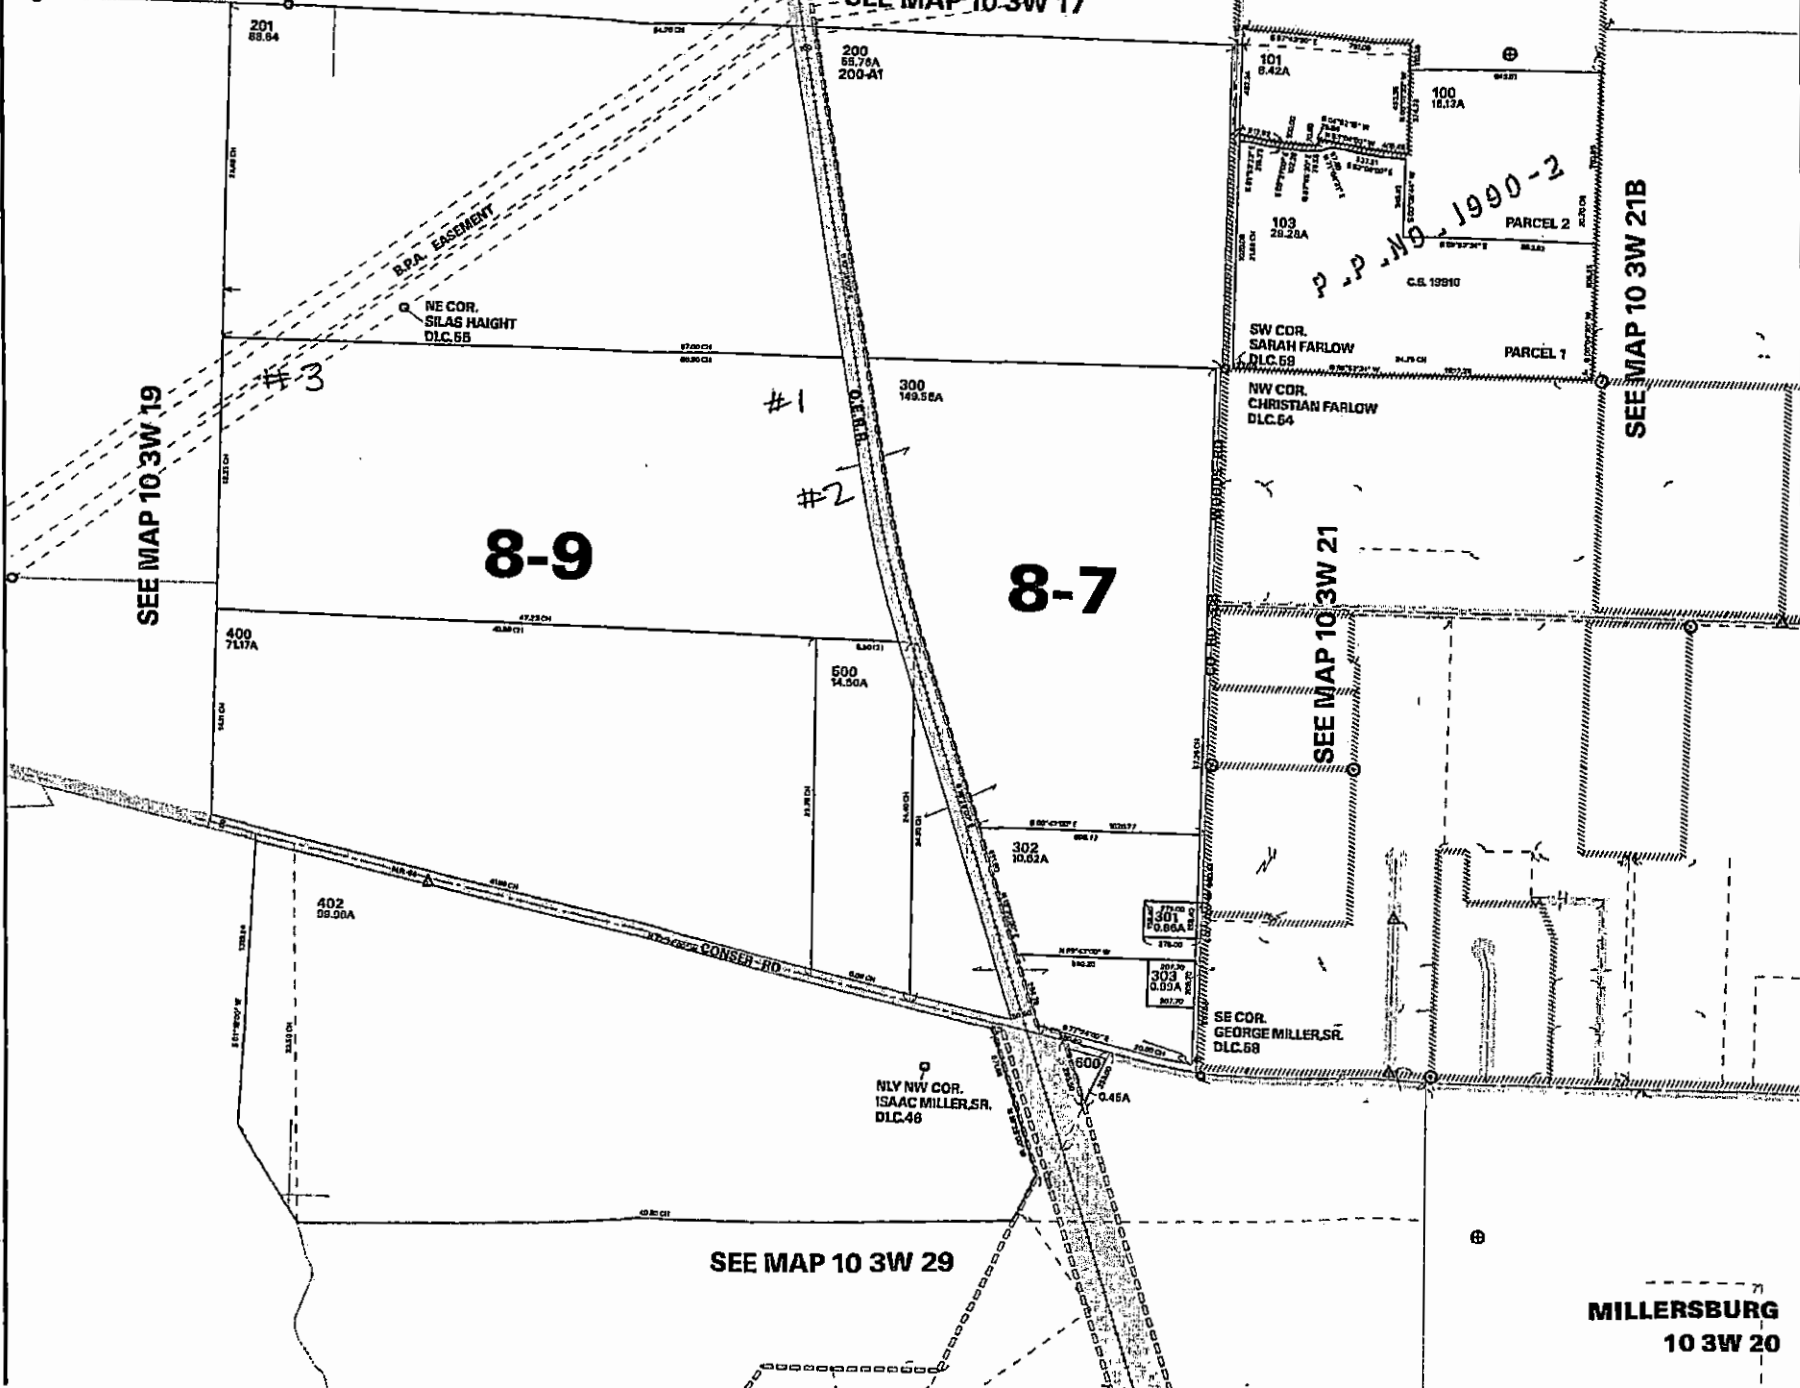

SEE MAP 10 3W 21B

SEE MAP 10 3W 21

SEE MAP 10 3W 29

SALEM, OR

SEP 08 2017

RECEIVED BY OWRD

MILLERSBURG
10 3W 20