

STATE ENGINEER  
Salem, Oregon

LINN  
6242

# Well Record

STATE WELL NO. 11/2W-2N  
COUNTY Linn  
APPLICATION NO. GR-3789

OWNER: Edward A. Rice


MAILING ADDRESS: Box 26

LOCATION OF WELL: Owner's No.

CITY AND STATE: Crabtree, Oregon

SW 1/4 SW 1/4 Sec. 2 T. 11 S., R. 2 W., W.M.

Bearing and distance from section or subdivision  
corner 1300' N. & 825' E. of SW Cor. Sec. 2

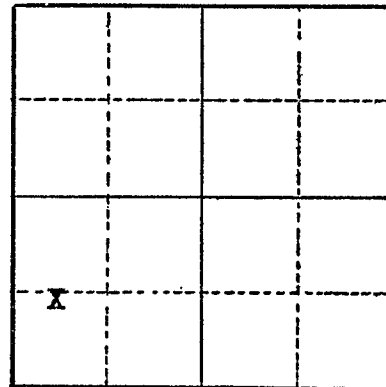

Section 2

Altitude at well

TYPE OF WELL: Dug Date Constructed May, 1955

Depth drilled 20 feet Depth cased 10 feet

### CASING RECORD:

Oil drum casing set to 10 feet

### FINISH:

None - dug well

### AQUIFERS:

### WATER LEVEL:

4 1/2 feet below surface

PUMPING EQUIPMENT: Type 3" x 2 1/2" centrifugal H.P. 3  
Capacity G.P.M.

### WELL TESTS:

Drawdown ft. after hours G.P.M.

Drawdown ft. after hours G.P.M.

USE OF WATER Irrigation Temp. °F., 19

SOURCE OF INFORMATION Well Registration Statement

DRILLER or DIGGER Edward A. Rice

### ADDITIONAL DATA:

Log Water Level Measurements Chemical Analysis Aquifer Test

### REMARKS:

3450