

STATE ENGINEER
Salem, Oregon

LINN
6284
Well Record

STATE WELL NO. *11/2W-3P(1)*
COUNTY *Linn*
APPLICATION NO. *GR-45*

OWNER: *Ira Young*

MAILING

ADDRESS: *Rt. 3, Box 115*

LOCATION OF WELL: Owner's No. *1*

CITY AND

STATE: *Scio, Oregon*

SE $\frac{1}{4}$ *SW* $\frac{1}{4}$ Sec. *3* T. *11* *N.* S. R. *2* *E.* W., W.M.


Bearing and distance from section or subdivision

corner *N. 43° W. 8 chs. from SE cor. SW $\frac{1}{4}$ Sec. 3*

Altitude at well *265 ft.* Interpolated

TYPE OF WELL: *dug* Date Constructed *Sept. 1952*

Depth drilled *10 ft.* Depth cased *10 ft.*

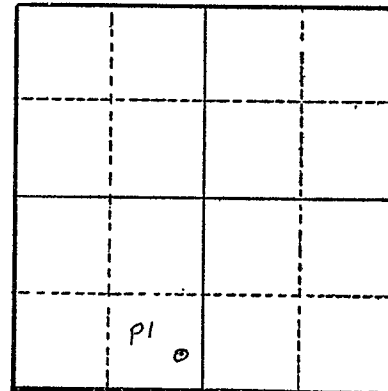

Section *3 & 10*

CASING RECORD: *36 inch steel oil drum set from 0 to 10 ft.*

FINISH: *Slit perforations set from 5 to 10 ft. 3 rows of perforations*
2 perf./foot

AQUIFERS: *Gravel, from 0 to 10 ft.*

WATER LEVEL: *4 ft. belowland surface Sept. 1952*

PUMPING EQUIPMENT: Type *Fairbanks Morse centrifugal 2 $\frac{1}{2}$ "* H.P. tractor eng.
Capacity *300* G.P.M.

WELL TESTS:

Drawdown *1* ft. after *500* hours G.P.M.

Drawdown *1* ft. after *500* hours G.P.M.

USE OF WATER *irrigation 17 acres* Temp. *19* °F.

SOURCE OF INFORMATION *Reg. St.*

DRILLER or DIGGER

ADDITIONAL DATA:

Log *X* Water Level Measurements *X* Chemical Analysis *X* Aquifer Test *X*

REMARKS: Log: *Gravel, river* *0 to 10 ft.*