

STATE ENGINEER
Salem, Oregon

Well Record

STATE WELL NO. 11/2W-3Q
COUNTY LINN
APPLICATION NO. GR-2449

OWNER: Elmer and Agnes Boshart

MAILING

ADDRESS: Rt. 3, Box 117

LOCATION OF WELL: Owner's No. _____


CITY AND

STATE: Scio, Oregon

SW $\frac{1}{4}$ SE $\frac{1}{4}$ Sec. 3 T. 11 S. R. 2 W., W.M.

Bearing and distance from section or subdivision

corner 1254' N. and 2310' W.

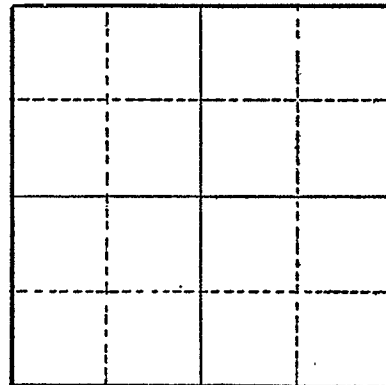

Section _____

Altitude at well _____

TYPE OF WELL: Drilled Date Constructed 1951

Depth drilled 25 Depth cased _____

CASING RECORD:

6-inch

FINISH:

AQUIFERS:

WATER LEVEL:

12-feet

PUMPING EQUIPMENT: Type Fairbanks Morse Centrifugal H.P. 5
Capacity 100 G.P.M.

WELL TESTS:

Drawdown _____ ft. after _____ hours _____ G.P.M.

Drawdown _____ ft. after _____ hours _____ G.P.M.

USE OF WATER Irrigation Temp. _____ °F. _____, 19____

SOURCE OF INFORMATION GR-2321

DRILLER or DIGGER Nicholas Klaus, Route 4, Albany, Oregon

ADDITIONAL DATA:

Log _____ Water Level Measurements _____ Chemical Analysis _____ Aquifer Test _____

REMARKS: