

STATE ENGINEER
Salem, Oregon

LINN
6292

Well Record

STATE WELL NO. 11/2W-4D
COUNTY LINN
APPLICATION NO. GR-2533

OWNER: M. E. & Della Walker

MAILING ADDRESS: Rt. 1, Box 272


LOCATION OF WELL: Owner's No.

CITY AND STATE: Albany, Oregon

NW 1/4 NW 1/4 Sec. 4 T. 11 S., R. 2 W., W.M.

Bearing and distance from section or subdivision

corner 1254' and 924' E.

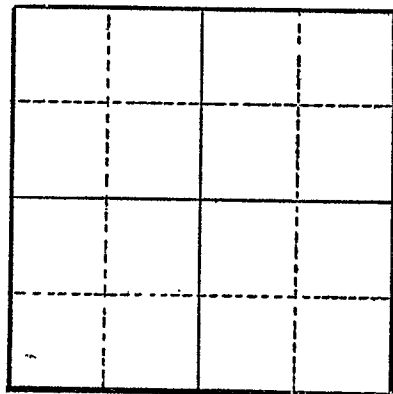

Section

Altitude at well

TYPE OF WELL: Drilled Date Constructed 1934

Depth drilled 20 Depth cased 20

CASING RECORD:

8-inch

FINISH:

Slot perforations from 14 to 20

AQUIFERS:

WATER LEVEL:

PUMPING EQUIPMENT: Type Demming Rotary H.P. 15
Capacity G.P.M.

WELL TESTS:

Drawdown ft. after hours G.P.M.
Drawdown ft. after hours G.P.M.

USE OF WATER Irrigation Temp. °F., 19

SOURCE OF INFORMATION GR-2375

DRILLER or DIGGER M. E. Walker, Albany, Oregon

ADDITIONAL DATA:

Log Water Level Measurements Chemical Analysis Aquifer Test

REMARKS: