

STATE ENGINEER
Salem, Oregon

LINN
6294

Well Record

STATE WELL NO. 11/2W - 4E
COUNTY LINN
APPLICATION NO. GR-2025

OWNER: Earl and Edith Pomeroy

MAILING ADDRESS: Rt. 1, Box 273


LOCATION OF WELL: Owner's No. _____

CITY AND STATE: Albany, Oregon

SW ¼ NW ¼ Sec. 4 T. 11 S., R. 2 W., W.M.

Bearing and distance from section or subdivision

corner 2904' N. and 891' E.

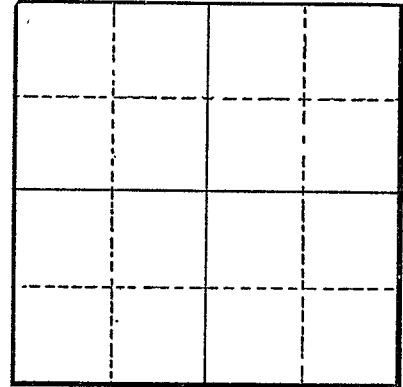

Section _____

Altitude at well _____

TYPE OF WELL: Drilled Date Constructed 1946

Depth drilled 30 Depth cased 30

CASING RECORD:

6-inch

FINISH:

Perforations from 20 to 30

AQUIFERS:

WATER LEVEL:

10-feet

PUMPING EQUIPMENT: Type 1½" Centrifugal
Capacity 200 G.P.M.

H.P. 7½

WELL TESTS:

Drawdown _____ ft. after _____ hours _____ G.P.M.

Drawdown _____ ft. after _____ hours _____ G.P.M.

USE OF WATER Irrigation

Temp. _____ °F., 19 _____

SOURCE OF INFORMATION GR-1951

DRILLER or DIGGER _____

ADDITIONAL DATA:

Log _____ Water Level Measurements _____ Chemical Analysis _____ Aquifer Test _____

REMARKS: