

STATE ENGINEER
Salem, Oregon

LINN
6303

Well Record

STATE WELL NO. 11/2W-5A(1)
COUNTY Linn
APPLICATION NO. GR-199

OWNER: Frank L. & Pansy Richardson


MAILING ADDRESS: Rt. 1, Box 271

LOCATION OF WELL: Owner's No. 1

CITY AND STATE: Albany, Oregon

NE 1/4 NE 1/4 Sec. 5 T. 11 S., R. 2 W., W.M.

Bearing and distance from section or subdivision
corner S. 6° E. 16 chs. from NE cor. John A. Powell
DLC 40, Sec. 5

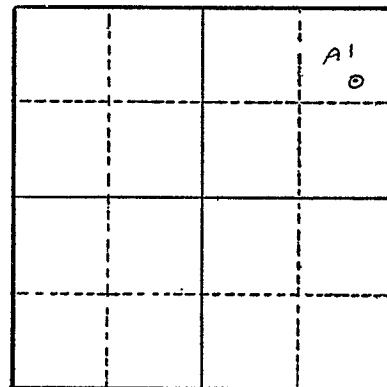

Section 5

Altitude at well 253 ft. Interpolated

TYPE OF WELL: dug Date Constructed 5/1/43

Depth drilled 26 ft. Depth cased 18 ft.

CASING RECORD: 36 inch concrete pipe set from 0 to 8 ft.
lumber line set from 8 to 18 ft.

FINISH: none

AQUIFERS: Sand and gravel from 3 to 26 ft.

WATER LEVEL: 10 ft. below land surface

PUMPING EQUIPMENT: Type 2 1/2" Allis Chalmers centrifugal H.P. 15
Capacity 300 G.P.M.

WELL TESTS:
Drawdown 15 ft. after hours pumping 400 G.P.M.
Drawdown ft. after hours G.P.M.

USE OF WATER irrigation 25 acres Temp. °F., 19

SOURCE OF INFORMATION Reg. St. GR-199

DRILLER or DIGGER

ADDITIONAL DATA:

Log ^X Water Level Measurements Chemical Analysis Aquifer Test

REMARKS: Log: Topsoil 0 to 3 ft.
Sand & gravel 3 to 26 ft.