

STATE ENGINEER  
Salem, Oregon

LINN  
6304

# Well Record

STATE WELL NO. 11/2W-5B(1)  
COUNTY Linn  
APPLICATION NO. GR-903

OWNER: Lloyd J. Porter


MAILING ADDRESS: Rt. 1, Box 269

LOCATION OF WELL: Owner's No. 2

CITY AND STATE: Albany, Oregon

NW 1/4 NE 1/4 Sec. 5 T. 11 S., R. 2 W., W.M.

Bearing and distance from section or subdivision corner S. 56° 20' W. 20.75 chs. from NE cor.  
DLC 40

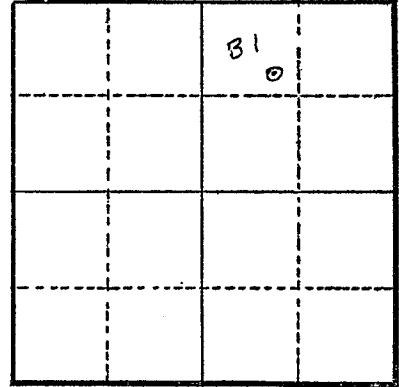

Altitude at well 255 ft.

TYPE OF WELL: drilled Date Constructed Apr. 1949

Depth drilled 28 ft. Depth cased 28 ft.

Section 5

CASING RECORD: 8 in. diameter steel 0 to 28 ft.

FINISH: Slot perforations 20 to 28 ft.

AQUIFERS:

WATER LEVEL: 16 ft.

PUMPING EQUIPMENT: Type centrifugal 3" H.P. 15 elec.  
Capacity 450 G.P.M.

WELL TESTS:  
Drawdown 5 ft. after 500 hours G.P.M.  
Drawdown ft. after hours G.P.M.

USE OF WATER irrigation Temp. °F., 19

SOURCE OF INFORMATION owner

DRILLER or DIGGER

ADDITIONAL DATA:

Log Water Level Measurements Chemical Analysis Aquifer Test

REMARKS: