

STATE ENGINEER  
Salem, Oregon

LINN  
6305

# Well Record

GR- 1289

STATE WELL NO. 11/2W-5B(2)  
COUNTY Linn  
APPLICATION NO. GR-1334

OWNER: Jay & Luanne Richardson


MAILING ADDRESS: Rt.1, Box 270

LOCATION OF WELL: Owner's No. #4

CITY AND STATE: Albany, Oregon

NW  $\frac{1}{4}$  NE  $\frac{1}{4}$  Sec. 5 T. 11 S., R. 2 W., W.M.

Bearing and distance from section or subdivision corner 990' S. & 1584' W. from NE. Cor. Sec. 5.

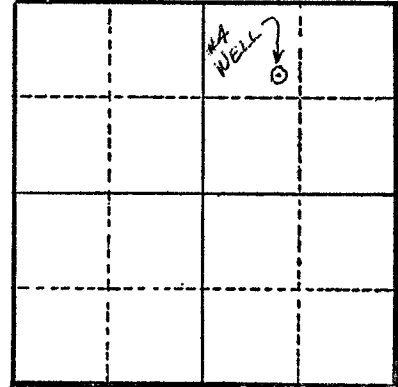

Section 5

Altitude at well 255 ft.

TYPE OF WELL: Drilled Date Constructed 1947

Depth drilled 28 ft. Depth cased 27 ft.

### CASING RECORD:

6 inch

### FINISH:

Perforated: Slotted from 21 to 27 ft.

### AQUIFERS:

### WATER LEVEL:

16 ft.

PUMPING EQUIPMENT: Type A. C. 2 in. Cent. H.P. 7 $\frac{1}{2}$

Capacity 250 G.P.M.

### WELL TESTS:

Drawdown ..... ft. after ..... hours ..... G.P.M.

Drawdown ..... ft. after ..... hours ..... G.P.M.

USE OF WATER Irrigation Temp. ..... °F. ...., 19.....

SOURCE OF INFORMATION G. R. Record

DRILLER or DIGGER .....

### ADDITIONAL DATA:

Log N.A. Water Level Measurements ..... Chemical Analysis ..... Aquifer Test .....

### REMARKS:

Irrigation of 15 acres.