

STATE ENGINEER
Salem, Oregon

LINN
6306

Well Record

STATE WELL NO. 11/2W - 5C
COUNTY LINN
APPLICATION NO. GR-2164

OWNER: Earl A. and Grace L. Miller


MAILING ADDRESS: Rt. 1, Box 263 D.

LOCATION OF WELL: Owner's No. #1

CITY AND STATE: Albany, Oregon

NE 1/4 NW 1/4 Sec. 5 T. 11 N. S., R. 2 W., W.M.

Bearing and distance from section or subdivision corner 990' S. and 1914' E.

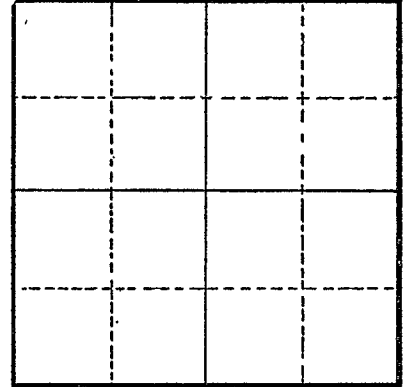

Section

Altitude at well

TYPE OF WELL: Drilled Date Constructed 1949

Depth drilled 21 Depth cased 21

CASING RECORD:

4-Inches

FINISH:

AQUIFERS:

WATER LEVEL: 10-Feet

PUMPING EQUIPMENT: Type Centrifugal H.P. 5
Capacity 150 G.P.M.

WELL TESTS:

Drawdown ft. after hours G.P.M.
Drawdown ft. after hours G.P.M.

USE OF WATER Irrigation Temp. °F., 19

SOURCE OF INFORMATION GR-2074

DRILLER or DIGGER Ed. Settlemeir, 1815 East First Avenue, Albany, Oregon

ADDITIONAL DATA:

Log Water Level Measurements Chemical Analysis Aquifer Test

REMARKS: