

STATE ENGINEER
Salem, Oregon

LINN
6309


Well Record

STATE WELL NO. 11/2W-50(2)
COUNTY Linn
APPLICATION NO. GR-583

OWNER: Kyle & Mary Folsom MAILING ADDRESS: Rt. 1, Box 268M

LOCATION OF WELL: Owner's No. 1 CITY AND STATE: Albany, Oregon

NE 1/4 NW 1/4 Sec. 5 T. 11 S., R. 2 W., W.M.
Bearing and distance from section or subdivision corner S. 69° 40' W. 45 chs. from NE cor. D1C 40

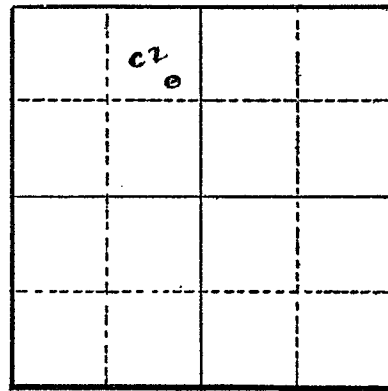

Section 5

Altitude at well 250 ft.

TYPE OF WELL: drilled Date Constructed 11/2/46
Depth drilled 20 1/2 ft. Depth cased 20 1/2 ft.

CASING RECORD: 10 inch

FINISH:

AQUIFERS:

WATER LEVEL: 8 ft.

PUMPING EQUIPMENT: Type Allis Chalmers & Cornell centrifugals H.P. 10 & 15
Capacity 300 & 420 G.P.M.

WELL TESTS:
Drawdown 1 1/2 ft. after _____ hours 1000 G.P.M.
Drawdown _____ ft. after _____ hours _____ G.P.M.

USE OF WATER irrigation 60.9 acres Temp. _____ °F., 19.

SOURCE OF INFORMATION GR-583

DRILLER or DIGGER Slate Drilling Co.; Tangent, Oregon

ADDITIONAL DATA:
Log _____ Water Level Measurements _____ Chemical Analysis _____ Aquifer Test _____

REMARKS: