

STATE ENGINEER
Salem, Oregon

LINN
6310

Well Record

STATE WELL NO. 11/2W-5C(3)
COUNTY Linn
APPLICATION NO. GR-584

OWNER: Kyle & Mary Folsom


MAILING ADDRESS: Rt. 1, Box 268M

LOCATION OF WELL: Owner's No. _____

CITY AND STATE: Albany, Oregon

NE $\frac{1}{4}$ NW $\frac{1}{4}$ Sec. 5 T. 11 N. S., R. 2 E. W., W.M.

Bearing and distance from section or subdivision corner S. 89° 30' W. 36.5 chs. from NE cor. DLG 40

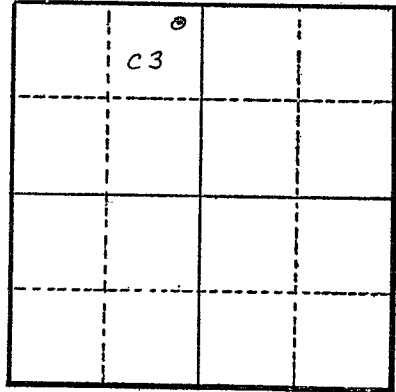

Section 5

Altitude at well 250 ft.

TYPE OF WELL: drilled Date Constructed 3/4/55

Depth drilled 28 ft. Depth cased 28 ft.

CASING RECORD: 8 inch

FINISH:

AQUIFERS:

WATER LEVEL: 8 ft.

PUMPING EQUIPMENT: Type Gardner Denver centrifugal H.P. 15
Capacity 500 G.P.M.

WELL TESTS:

Drawdown 2 ft. after _____ hours 1000 G.P.M.

Drawdown _____ ft. after _____ hours _____ G.P.M.

USE OF WATER irrigation 12.2 acres Temp. _____ °F. _____, 19

SOURCE OF INFORMATION GR-584

DRILLER or DIGGER Nickolas Klaus; Albany, Oregon

ADDITIONAL DATA:

Log _____ Water Level Measurements _____ Chemical Analysis _____ Aquifer Test _____

REMARKS: