

STATE ENGINEER
Salem, Oregon

L/NN
6311

Well Record

STATE WELL NO. 11/2W-5C(4)
COUNTY Linn
APPLICATION NO. GR-928

OWNER: John J. & Mildred E. Loy


MAILING ADDRESS: Rt. 1, Box 267

LOCATION OF WELL: Owner's No.

CITY AND STATE: Albany, Oregon

NE 1/4 NW 1/4 Sec. 5 T. 11 S., R. 2 W., W.M.

Bearing and distance from section or subdivision corner 100' S. & 2508' E. of NW cor. Sec. 5

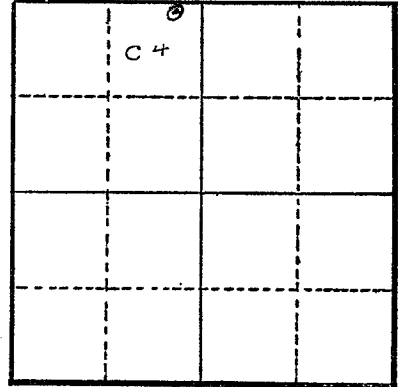

Section 5

Altitude at well 250 ft.

TYPE OF WELL: drilled Date Constructed June 1941

Depth drilled 26 ft. Depth cased 26 ft.

CASING RECORD: 6 in. steel 0 to 26 ft.

FINISH: Slot perforations 20 to 26 ft.

AQUIFERS:

WATER LEVEL: 11 ft.

PUMPING EQUIPMENT: Type 2" Allis Chalmers centrifugal H.P. 15 elec.
Capacity 280 G.P.M.

WELL TESTS:
Drawdown 6 in. after hours 400 G.P.M.
Drawdown ft. after hours G.P.M.

USE OF WATER irrigation Temp. °F. 19

SOURCE OF INFORMATION owner

DRILLER or DIGGER Nicholas Klaus

ADDITIONAL DATA:

Log Water Level Measurements Chemical Analysis Aquifer Test

REMARKS: