

STATE ENGINEER
Salem, Oregon

LINN
6312

Well Record

STATE WELL NO. 11/2W - 5D
COUNTY LINN
APPLICATION NO. GR-2163

OWNER: Earl A. and Grace L. Miller


MAILING ADDRESS: Rt. 1, Box 263 D.

LOCATION OF WELL: Owner's No. #2

CITY AND STATE: Albany, Oregon

NW 1/4 NW 1/4 Sec. 5 T. 11 N. S., R. 2 E. W., W.M.

Bearing and distance from section or subdivision corner 825' S. and 858' E.

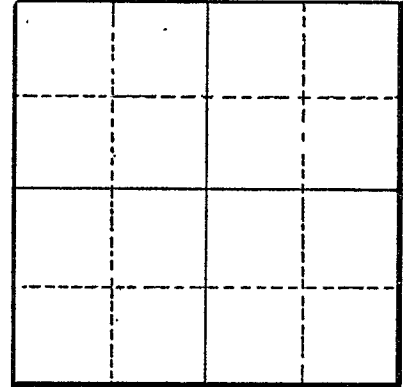

Section

Altitude at well

TYPE OF WELL: Drilled Date Constructed 1947

Depth drilled 28 Depth cased 28

CASING RECORD:

6-Inches

FINISH:

AQUIFERS:

WATER LEVEL:

PUMPING EQUIPMENT: Type Centrifugal H.P. 10
Capacity 300 G.P.M.

WELL TESTS:

Drawdown ft. after hours G.P.M.
Drawdown ft. after hours G.P.M.

USE OF WATER Irrigation Temp. °F., 19

SOURCE OF INFORMATION GR-2073

DRILLER or DIGGER Ed Settlemeir, 1815 East First Avenue, Albany, Oregon

ADDITIONAL DATA:

Log Water Level Measurements Chemical Analysis Aquifer Test

REMARKS: