

STATE ENGINEER
Salem, Oregon

LINN
6313

Well Record

STATE WELL NO. 11/2W-5D(1)
COUNTY Linn
APPLICATION NO. GR-435

OWNER: Elmer & Loretta Backman


MAILING ADDRESS: Rt. 1, Box 264

LOCATION OF WELL: Owner's No. 2

CITY AND STATE: Albany, Oregon

NW $\frac{1}{4}$ NW $\frac{1}{4}$ Sec. 5 T. 11 N. S., R. 2 E. W., W.M.

Bearing and distance from section or subdivision corner S. 7° 30' E. 18 chs. from NW cor. DLC 50

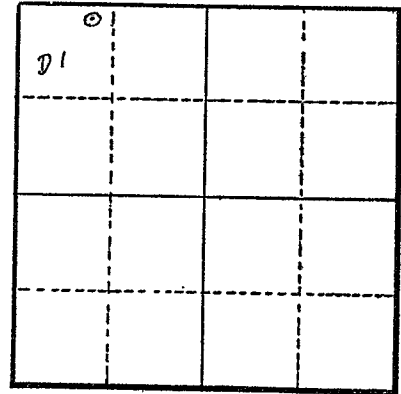

Section 5

Altitude at well 250 ft.

TYPE OF WELL: drilled Date Constructed 4/5/47

Depth drilled 25 ft. Depth cased 25 ft.

CASING RECORD: 10 inch

FINISH:

AQUIFERS:

WATER LEVEL: 12 ft.

PUMPING EQUIPMENT: Type _____ H.P. _____
Capacity _____ G.P.M.

WELL TESTS:
Drawdown 12 ft. after _____ hours 180 G.P.M.
Drawdown _____ ft. after _____ hours _____ G.P.M.

USE OF WATER irrigation 23.8 acres Temp. _____ °F. _____, 19____

SOURCE OF INFORMATION GR-435

DRILLER or DIGGER _____

ADDITIONAL DATA:

Log _____ Water Level Measurements _____ Chemical Analysis _____ Aquifer Test _____

REMARKS: