

STATE ENGINEER
Salem, Oregon

LINN
6314

Well Record

STATE WELL NO. 11/2W-5H(1)
COUNTY Linn
APPLICATION NO. GR-199

OWNER: Frank L. & Pansy Richardson

MAILING ADDRESS: Rt. 1, Box 271


LOCATION OF WELL: Owner's No. 2

CITY AND STATE: Albany, Oregon

SE 1/4 NE 1/4 Sec. 5 T. 11 N. S., R. 2 E. W., W.M.

Bearing and distance from section or subdivision corner S. 2° 40' E. 24.5 chs. from NE cor.

John A. Powell DLC 40

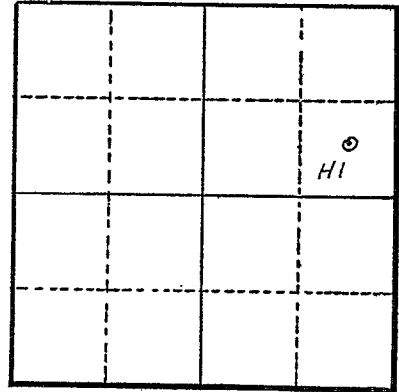

Section 5

Altitude at well 253 ft. Interpolated

TYPE OF WELL: driven Date Constructed 5/6/48

Depth drilled 23 ft. Depth cased 23 ft.

CASING RECORD: 5 inch steel casing from 0 to 23 ft.

FINISH: Slit perforations set from 18 to 23 ft.

AQUIFERS: Sand and gravel 4 to 23 ft.

WATER LEVEL: 11 ft. below land surface

PUMPING EQUIPMENT: Type Allis Chalmers centrifugal H.P. 15
Capacity 300 G.P.M.

WELL TESTS:
Drawdown 14 ft. after hours pumping 300 G.P.M.
Drawdown ft. after hours G.P.M.

USE OF WATER irrigation 12 acres Temp. °F. 19

SOURCE OF INFORMATION Reg. St. GR-199

DRILLER or DIGGER

ADDITIONAL DATA:

Log ^X Water Level Measurements Chemical Analysis Aquifer Test

REMARKS: Log: Soil 0 to 4 ft.
Sand & gravel 4 to 23 ft.