

STATE ENGINEER  
Salem, Oregon

LINN  
6315

# Well Record

STATE WELL NO. 11/2W-5H(2)  
COUNTY Linn  
APPLICATION NO. GR-199

OWNER: Frank L. & Pansy Richardson


MAILING ADDRESS: Rt. 1, Box 271

LOCATION OF WELL: Owner's No. 3

CITY AND STATE: Albany, Oregon

SE  $\frac{1}{4}$  NE  $\frac{1}{4}$  Sec. 5 T. 11 N. S., R. 2 E. W., W.M.

Bearing and distance from section or subdivision  
corner S. 28° W. 23.0 chs. from NE cor. John A. Powell DLC (Sec. 5)

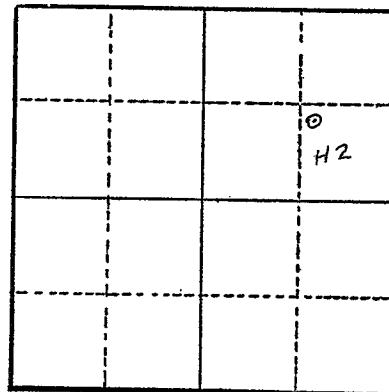

Section 5

Altitude at well 253 ft. Interpolated

TYPE OF WELL: dug Date Constructed 5/10/52

Depth drilled 10 ft. Depth cased 10 ft.

CASING RECORD: 72 inch lumber lined 0 to 10 ft.

FINISH: none

AQUIFERS: Sand and gravel from 3 to 10 ft.

WATER LEVEL: 7 ft. below land surface

PUMPING EQUIPMENT: Type 2 $\frac{1}{2}$ " Allis Chalmers centrifugal H.P. 15  
Capacity 300 G.P.M.

WELL TESTS:  
Drawdown 2 ft. after          hours          pumping 400 G.P.M.  
Drawdown          ft. after          hours          G.P.M.

USE OF WATER irrigation 6.5 acres Temp.          °F.         , 19        

SOURCE OF INFORMATION Reg. St. GR-199

DRILLER or DIGGER         

ADDITIONAL DATA:

Log X Water Level Measurements          Chemical Analysis          Aquifer Test         

REMARKS: Log: Soil- 0 to 3 ft.  
Sand & gravel 3 to 10 ft.