

STATE ENGINEER  
Salem, Oregon

LINN  
6316

# Well Record

STATE WELL NO. 11/2W-5J(1)  
COUNTY Linn  
APPLICATION NO. GR-476

OWNER: Bose Brothers


MAILING ADDRESS: Rt. 1, Box 260

LOCATION OF WELL: Owner's No. \_\_\_\_\_

CITY AND STATE: Albany, Oregon

NE 1/4 SE 1/4 Sec. 5 T. 11 N. S., R. 2 E. W., W.M.

Bearing and distance from section or subdivision corner N. 32° 20' W. 32.5 chs. from SE cor. Sec. 5

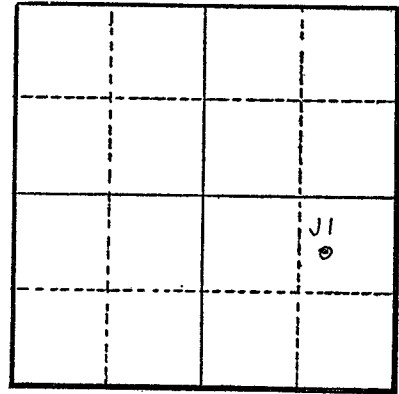

Section 5

Altitude at well 260 ft.

TYPE OF WELL: drilled Date Constructed 10/13/53

Depth drilled 30 ft. Depth cased 30 ft.

CASING RECORD: 10 inch

FINISH:

AQUIFERS:

WATER LEVEL: 15 ft.

PUMPING EQUIPMENT: Type Fairbanks Morse centrifugal H.P. 25  
Capacity 500 G.P.M.

WELL TESTS:  
Drawdown 5 ft. after \_\_\_\_\_ hours 500 G.P.M.  
Drawdown \_\_\_\_\_ ft. after \_\_\_\_\_ hours \_\_\_\_\_ G.P.M.

USE OF WATER irrigation 67 acres Temp. \_\_\_\_\_ °F. \_\_\_\_\_, 19\_\_\_\_

SOURCE OF INFORMATION GR-476

DRILLER or DIGGER Raymond Gellatly; Philomath, Oregon

ADDITIONAL DATA:

Log \_\_\_\_\_ Water Level Measurements \_\_\_\_\_ Chemical Analysis \_\_\_\_\_ Aquifer Test \_\_\_\_\_

REMARKS: