

STATE ENGINEER
Salem, Oregon

LINN
6317

Well Record

GR- 1723

STATE WELL NO. 11/2W-5M
COUNTY Linn
APPLICATION NO. GR- 1779

OWNER: Earl K. & Cora E. Miller


MAILING ADDRESS: Rt. 1, Box 275

LOCATION OF WELL: Owner's No.

CITY AND STATE: Albany, Oregon

NW 1/4 SW 1/4 Sec. 5 T. 11 S., R. 2 W., W.M.

Bearing and distance from section or subdivision corner 2376' N. & 100' E. from SW cor. Sec. 5

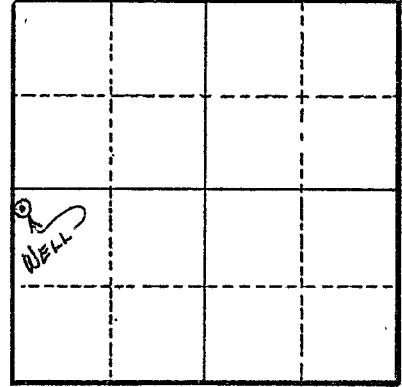

Section 5

Altitude at well 230'

TYPE OF WELL: Drilled Date Constructed 1946

Depth drilled 70' Depth cased 70'

CASING RECORD:

8"

FINISH:

Slot perforations from 50 to 70 ft.

AQUIFERS:

WATER LEVEL:

21'

PUMPING EQUIPMENT: Type Peerless turbine H.P. 5

Capacity 70 G.P.M.

WELL TESTS:

Drawdown ft. after hours G.P.M.

Drawdown ft. after hours G.P.M.

USE OF WATER Irrigation Temp. °F. 19

SOURCE OF INFORMATION GR Record

DRILLER or DIGGER Sloper Well Drilling Co.

ADDITIONAL DATA:

Log N.A. Water Level Measurements Chemical Analysis Aquifer Test

REMARKS:

Irrigation of 14 acres.