

STATE ENGINEER
Salem, Oregon

LINN
6319

Well Record


STATE WELL NO. 11/2W-5R(1)
COUNTY Linn
APPLICATION NO. GR-372

OWNER: Wilbert & Jane Bilyeu
MAILING ADDRESS: Rt. 1, Box 259

LOCATION OF WELL: Owner's No. _____
CITY AND STATE: Albany, Oregon

SE 1/4 SE 1/4 Sec. 5 T. 11 N. S., R. 2 E. W., W.M.

Bearing and distance from section or subdivision
corner N. 3° 30' W. 19.50 chs. from SE cor. Sec. 5

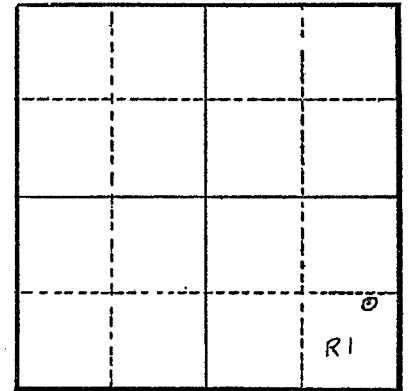

Section 5

Altitude at well 260 ft.

TYPE OF WELL: driven Date Constructed 5/16/49

Depth drilled 20 ft. Depth cased 20 ft.

CASING RECORD: 4 inch

FINISH:

AQUIFERS:

WATER LEVEL: 8 ft.

PUMPING EQUIPMENT: Type Pacific centrifugal H.P. 10
Capacity 220 G.P.M.

WELL TESTS:
Drawdown _____ ft. after _____ hours _____ G.P.M.
Drawdown _____ ft. after _____ hours _____ G.P.M.

USE OF WATER irrigation Temp. _____ °F. _____, 19

SOURCE OF INFORMATION applicant
DRILLER or DIGGER applicant

ADDITIONAL DATA:
Log _____ Water Level Measurements _____ Chemical Analysis _____ Aquifer Test _____

REMARKS: