

STATE ENGINEER
Salem, Oregon

LINN
6335

Well Record

STATE WELL NO. 11/2W-6K(1)
COUNTY Linn
APPLICATION NO. GR-1111

GR-1071 6-6223

OWNER: Ernest and Lena Gourley

MAILING ADDRESS: Rt. 1, Box 276


LOCATION OF WELL: Owner's No. _____

CITY AND STATE: Albany, Oregon

NW 1/4 SE 1/4 Sec. 6 T. 11 S., R. 2 W., W.M.

Bearing and distance from section or subdivision

corner S72°15'W. 13 ch. from NE cor. of the
Reuben Streithoff DIC #37.

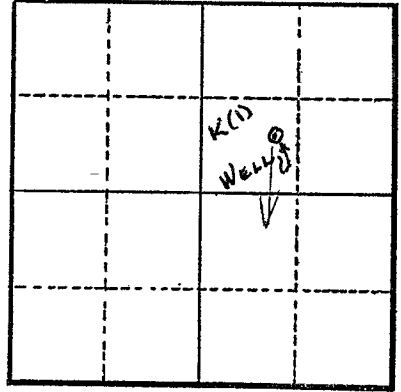

Section 6

Altitude at well 250 ft.

TYPE OF WELL: Drilled Date Constructed 1940

Depth drilled 60 ft. Depth cased 60 ft.

CASING RECORD:

8 inch

FINISH:

Slit perforations from 48 to 60 ft.

AQUIFERS:

WATER LEVEL:

10 ft.

PUMPING EQUIPMENT: Type Pacific Deep Well Turbine H.P. 15

Capacity 300 G.P.M.

WELL TESTS:

Drawdown 45 ft. after _____ hours 300 G.P.M.

Drawdown _____ ft. after _____ hours _____ G.P.M.

USE OF WATER Irrigation Temp. _____ °F. _____, 19____

SOURCE OF INFORMATION G. R. Record

DRILLER or DIGGER Willard Sloper

ADDITIONAL DATA:

Log N.A. Water Level Measurements _____ Chemical Analysis _____ Aquifer Test _____

REMARKS:

Irrigation of 58.4 acres.