

STATE ENGINEER
Salem, Oregon

LINN
6342

Well Record

STATE WELL NO. 11/2W-7H
COUNTY Linn
APPLICATION NO. GR-3959

OWNER: Wilson Young

MAILING
ADDRESS:

LOCATION OF WELL: Owner's No.


CITY AND
STATE:

Albany, Oregon

SE 1/4 NE 1/4 Sec. 7 T. 11 S. R. 2 W., W.M.

Bearing and distance from section or subdivision

corner 4.50 chs. N. 88°40' E. from NE Cor. DLG 44

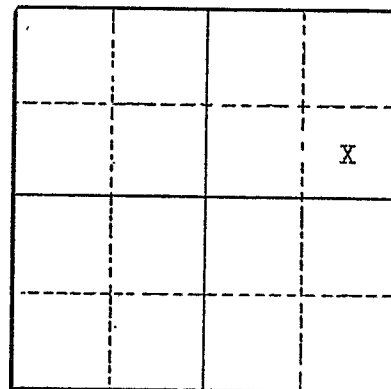

Section 7

Altitude at well

TYPE OF WELL: Drilled Date Constructed 8/20/52

Depth drilled 100 ft. Depth cased 80 ft.

CASING RECORD:

8 inch steel well casing set to 80 feet

FINISH:

2" x 4" opening 4 per foot from 20 to 80 feet

AQUIFERS:

WATER LEVEL:

8 feet below surface

PUMPING EQUIPMENT: Type Fairbanks Morse 4" turbine H.P. 7 1/2
Capacity 250 G.P.M.

WELL TESTS:

Drawdown 22 ft. after hours 250 G.P.M.

Drawdown ft. after hours G.P.M.

USE OF WATER Irrigation Temp. °F. 19

SOURCE OF INFORMATION Well Registration Statement Cert. # GR-3579

DRILLER or DIGGER

ADDITIONAL DATA:

Log X Water Level Measurements Chemical Analysis Aquifer Test

REMARKS: Log:

	Thickness	Depth to Bottom
Loam	18	18
Water bearing gravel	4	22
Sandy clay	9	31
Water bearing gravel	67	100
Clay		