

STATE ENGINEER
Salem, Oregon

LINN
6371

Well Record

STATE WELL NO. 11/2W-8B(1)
COUNTY Linn
APPLICATION NO. GR-649

OWNER: Ernest J. Richards


MAILING ADDRESS: Rt. 1, Box 258

LOCATION OF WELL: Owner's No. 1

CITY AND STATE: Albany, Oregon

NW 1/4 NE 1/4 Sec. 8 T. 11 N. S. R. 2 E. W.M.

Bearing and distance from section or subdivision corner S. 87° 10' W. 22.5 chs. from NE cor. Sec. 8

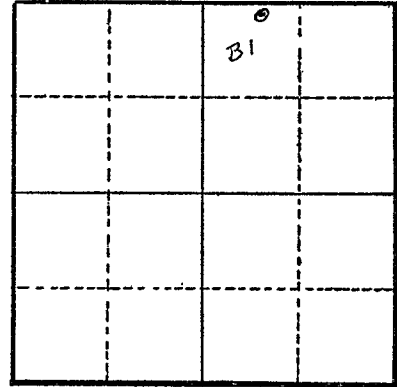

Altitude at well 260 ft. Interpolated

TYPE OF WELL: drilled Date Constructed Aug. 1946

Depth drilled 30 ft. Depth cased 30 ft.

Section 8

CASING RECORD: 12 inch

FINISH:

AQUIFERS:

WATER LEVEL: 9 ft.

PUMPING EQUIPMENT: Type Pacific centrifugal H.P. 10
Capacity 225 G.P.M.

WELL TESTS:
Drawdown 13 ft. after _____ hours 350 G.P.M.
Drawdown _____ ft. after _____ hours _____ G.P.M.

USE OF WATER irrigation 22 acres Temp. _____ °F. _____, 19

SOURCE OF INFORMATION GR-649

DRILLER or DIGGER Bill Hamilton; Albany, Oregon

ADDITIONAL DATA:

Log _____ Water Level Measurements _____ Chemical Analysis _____ Aquifer Test _____

REMARKS: