

STATE ENGINEER
Salem, Oregon

LINN 6372
Well Record

STATE WELL NO. 11/2W-8E(1)
COUNTY Linn
APPLICATION NO. GR-358

OWNER: R. L. & Rhoda B. Jackson

MAILING ADDRESS: Rt. 1, Box 253


LOCATION OF WELL: Owner's No.

CITY AND STATE: Albany, Oregon

SW $\frac{1}{4}$ NW $\frac{1}{4}$ Sec. 8 T. 11 N. S., R. 2 E. W., W.M.

Bearing and distance from section or subdivision

corner S. $71^{\circ} 10'$ E. 21.3 chs. from NW cor. DLO 43

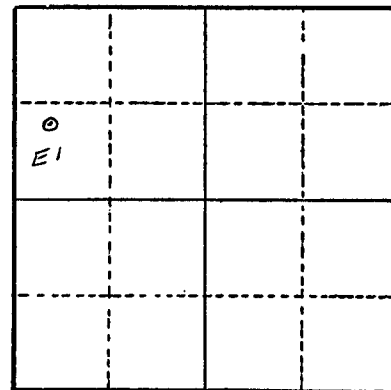

Altitude at well 260 ft.

TYPE OF WELL: drilled Date Constructed 4/15/52

Depth drilled 118 ft. Depth cased 90 ft.

Section 8

CASING RECORD: 10 inch

FINISH:

AQUIFERS:

WATER LEVEL: 15 ft.

PUMPING EQUIPMENT: Type Peerless deep well H.P. $7\frac{1}{2}$
Capacity 150 G.P.M.

WELL TESTS:

Drawdown ft. after hours G.P.M.

Drawdown ft. after hours G.P.M.

USE OF WATER irrigation Temp. $^{\circ}$ F. , 19

SOURCE OF INFORMATION Ground Water Reg. Record

DRILLER or DIGGER Shaffer & Gellatly; Philomath, Oregon

ADDITIONAL DATA:

Log ☒ Water Level Measurements Chemical Analysis Aquifer Test

REMARKS:

Driller: Shafer & Gellatly Date Drilled