

STATE ENGINEER  
Salem, Oregon

LINN  
6373

# Well Record

STATE WELL NO. 11/2W-8J  
COUNTY LINN  
~~APPLICATION NO.~~ CR-2295

OWNER: Karl and Beatrice Arnold


MAILING ADDRESS: Rt. 1, Box 279

LOCATION OF WELL: Owner's No. \_\_\_\_\_

CITY AND STATE: Albany, Oregon

NE  $\frac{1}{4}$  SE  $\frac{1}{4}$  Sec. 8 T. 11 N. S., R. 2 E. W., W.M.

Bearing and distance from section or subdivision corner N. 31° 45' E. 15.75 chains from Inter.  
cor. on S. Line DLG 43.

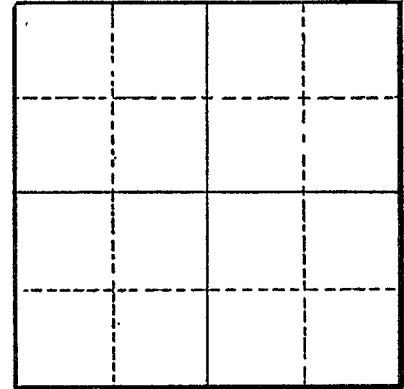

Section \_\_\_\_\_

Altitude at well \_\_\_\_\_

TYPE OF WELL: Drilled Date Constructed 1953

Depth drilled 110 Depth cased 110

### CASING RECORD:

10-inch

### FINISH:

Slot perforations from 95 to 110

### AQUIFERS:

### WATER LEVEL:

21-feet

PUMPING EQUIPMENT: Type Peerless Deep Well Turbine H.P. 10  
Capacity 200 G.P.M.

### WELL TESTS:

Drawdown 84 ft. after \_\_\_\_\_ hours Pumping 285 G.P.M.  
Drawdown \_\_\_\_\_ ft. after \_\_\_\_\_ hours \_\_\_\_\_ G.P.M.

USE OF WATER Irrigation Temp. \_\_\_\_\_ °F., 19

SOURCE OF INFORMATION CR-2190

DRILLER or DIGGER C. Burkhart

### ADDITIONAL DATA:

Log \_\_\_\_\_ Water Level Measurements \_\_\_\_\_ Chemical Analysis \_\_\_\_\_ Aquifer Test \_\_\_\_\_

### REMARKS: