

STATE ENGINEER
Salem, Oregon

LINN
6405

Well Record

STATE WELL NO. 11/2W-9A(1)
COUNTY Linn
APPLICATION NO. GR-536

OWNER: Varda & L. L. Baltimore


MAILING ADDRESS: Rt. 1, Box 295K

LOCATION OF WELL: Owner's No.

CITY AND STATE: Albany, Oregon

NE 1/4 NE 1/4 Sec. 9 T. 11 S., R. 2 E., W.M.

Bearing and distance from section or subdivision
corner S. 14° W. 7.5 chs. from NE cor. Sec. 9

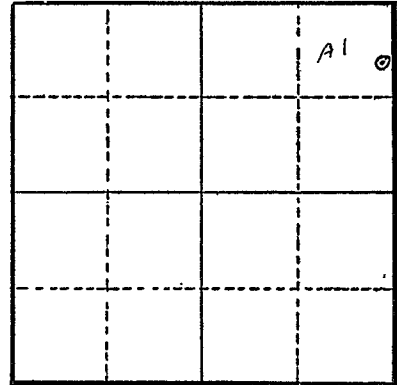

Section9.....

Altitude at well 265 ft.

TYPE OF WELL: drilled Date Constructed 1947

Depth drilled 24 ft. Depth cased 24 ft.

CASING RECORD: 12 inch

FINISH:

AQUIFERS:

WATER LEVEL: 12 ft.

PUMPING EQUIPMENT: Type Fairbanks Morse centrifugal H.P. 5
Capacity 200 G.P.M.

WELL TESTS:
Drawdown 4 ft. after 300 hours G.P.M.
Drawdown ft. after hours G.P.M.

USE OF WATER irrigation 8.2 acres Temp. °F., 19
SOURCE OF INFORMATION GR-536

DRILLER or DIGGER
ADDITIONAL DATA:

Log Water Level Measurements Chemical Analysis Aquifer Test

REMARKS: