

STATE ENGINEER  
Salem, Oregon

LINN  
6408

# Well Record

STATE WELL NO. 11/2W-9B(1)  
COUNTY Linn  
APPLICATION NO. GR-434

OWNER: Will E. White


MAILING ADDRESS: Rt. 1, Box 293M

LOCATION OF WELL: Owner's No.

CITY AND STATE: Albany, Oregon

NW 1/4 NE 1/4 Sec. 9 T. 11 N. S. R. 2 E. W., W.M.

Bearing and distance from section or subdivision corner S. 79° 45' E. 29.4 chs. from NE cor. N. Proj. of DLG 42

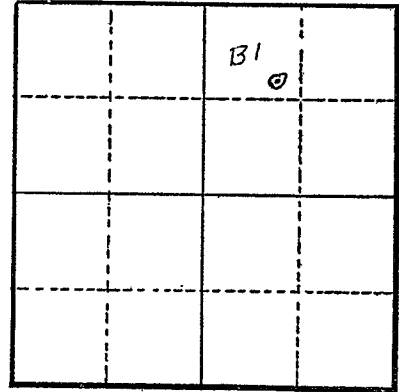

Section 9

Altitude at well 270 ft.

TYPE OF WELL: drilled Date Constructed 5/11/54

Depth drilled 25 ft. Depth cased 25 ft.

CASING RECORD: 6 inch

FINISH:

AQUIFERS:

WATER LEVEL: 12 ft.

PUMPING EQUIPMENT: Type Pacific centrifugal H.P.29  
Capacity 280 G.P.M.

WELL TESTS:

Drawdown ft. after hours G.P.M.

Drawdown ft. after hours G.P.M.

USE OF WATER irrigation 7.2 acres Temp. °F. 19

SOURCE OF INFORMATION GR-434

DRILLER or DIGGER Robert E. White; Lebanon, Oregon

ADDITIONAL DATA:

Log <sup>X</sup> Water Level Measurements Chemical Analysis Aquifer Test

REMARKS: Log: Soil 0 to 4 ft.  
Gravel & sand 4 to 19 ft.  
River rock 19 to 25 ft.