

STATE ENGINEER
Salem, Oregon

LINN
6409

Well Record

STATE WELL NO. 11/2W-9C
COUNTY Linn
APPLICATION NO. GR-3238

OWNER: J. E. Thomas


MAILING ADDRESS: Route 1, Box 285

LOCATION OF WELL: Owner's No.

CITY AND STATE: Albany, Oregon

NE 1/4 NW 1/4 Sec. 9 T. 11 N S, R. 2 E W, W.M.

Bearing and distance from section or subdivision corner 660' S. and 1715' E. of N.W. corner of Section 9

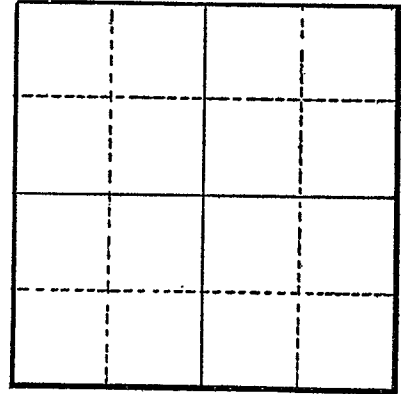

Section

Altitude at well

TYPE OF WELL: drilled Date Constructed 1949

Depth drilled 20 1/2 Depth cased 20 1/2

CASING RECORD:

10 inch

FINISH:

Slot perforations from 11 to 20 1/2

AQUIFERS:

WATER LEVEL:

9 feet

PUMPING EQUIPMENT: Type Fairbanks Morse Cent. H.P. 16
Capacity G.P.M.

WELL TESTS:

Drawdown ft. after hours pumping 600 G.P.M.
Drawdown ft. after hours G.P.M.

USE OF WATER Irrigation Temp. °F. 19

SOURCE OF INFORMATION GR-3015

DRILLER or DIGGER Bill Hamilton, Albany, Oregon

ADDITIONAL DATA:

Log Water Level Measurements Chemical Analysis Aquifer Test

REMARKS: