

STATE ENGINEER
Salem, Oregon

LINN
6415

Well Record

GR- 1505

STATE WELL NO. 11/2W-9L
COUNTY Linn
APPLICATION NO. GR- 1562

OWNER: M. L. Gingrich


MAILING ADDRESS: Rt. 1, Box 283

LOCATION OF WELL: Owner's No.

CITY AND STATE: Albany, Oregon

NE 1/4 SW 1/4 Sec. 9 T. 11 S., R. 2 W., W.M.

Bearing and distance from section or subdivision corner 2838' S. & 2112' E. from NW cor. Sec. 9

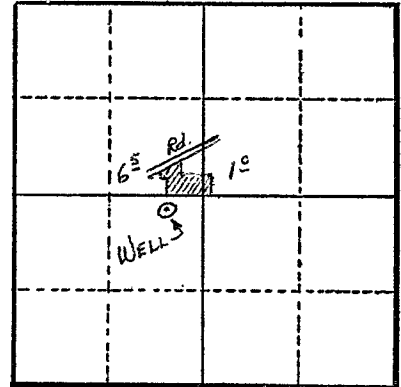

Section 9

Altitude at well 270'

TYPE OF WELL: Drilled Date Constructed 1953

Depth drilled 20' Depth cased 20'

CASING RECORD:
10"

FINISH:

Slot perforated from 14 to 20 ft.

AQUIFERS:

WATER LEVEL:

8'

PUMPING EQUIPMENT: Type Jacuzzi 3" Cent. H.P. 5
Capacity 200 G.P.M.

WELL TESTS:

Drawdown 4 ft. after 200 hours G.P.M.
Drawdown ft. after hours G.P.M.

USE OF WATER Irrigation Temp. °F. 19

SOURCE OF INFORMATION GR Record

DRILLER or DIGGER Bill Hamilton

ADDITIONAL DATA:

Log N.A. Water Level Measurements Chemical Analysis Aquifer Test

REMARKS:

Irrigation of 7.5 acres.