

Amended 9/15/2023
 STATE OF OREGON
 WATER SUPPLY WELL REPORT

RECEIVED

SEP 01 2023

WELL I.D. LABEL# L 143508
 START CARD # 1070336
 ORIGINAL LOG #

(as required by ORS 537.545 & 537.765 and OAR 690-205-0210)

(1) LAND OWNER Owner Well I.D. 6500
 First Name _____ Last Name _____
 Company Mid Valley Farms Inc.
 Address 31915 Seven Mile Ln.
 City Tangent State OR Zip 97389

OWNED

LINN 64308

(2) TYPE OF WORK New Well Deepening Conversion
 Alteration (complete 2a & 10) Abandonment (complete 5a)

(2a) PRE-ALTERATION
 Dia + From To Gauge Stil Plstc Wld Thrd
 Casing:
 Material From To Amt sacks/lbs
 Seal: _____

(3) DRILL METHOD
 Rotary Air Rotary Mud Cable Auger Cable Mud
 Reverse Rotary Other _____

(4) PROPOSED USE Domestic Irrigation Community
 Industrial/ Commercial Livestock Dewatering
 Thermal Injection Other _____

(5) BORE HOLE CONSTRUCTION Special Standard (Attach copy)
 Depth of Completed Well 320 ft.

BORE HOLE			SEAL			sacks/
Dia	From	To	Material	From	To	Amt lbs
16	20	180	Cement	2	62	35 S
18	0	20			Calculated	31
10	180	320	Bentonite	0	2	2 S
					Calculated	2

How was seal placed: Method A B C D E
 Other Poured dry
 Backfill placed from _____ ft. to _____ ft. Material _____
 Filter pack from _____ ft. to _____ ft. Material _____ Size _____
 Seal Placement Begin Date 7/21/23 Begin Time 11 AM

(5a) ABANDONMENT USING UNHYDRATED BENTONITE
 Proposed Amount Pounds Actual Amount Pounds

(6) CASING/LINER
 Casing Liner Dia + From To Gauge Stil Plstc Wld Thrd

 Shoe Inside Outside Other Location of shoe(s) _____
 Temp casing Yes Dia _____ From + _____ To _____

(7) PERFORATIONS/SCREENS
 Perforations Method Torch cut
 Screens Type _____ Material _____
 Perf/S Casing/Screen Scm/slot Slot # of Tele/
 creen Liner Dia From To width length slots pipe size

Perf	Casing		70	183	25	12	720	
------	--------	--	----	-----	----	----	-----	--

(8) WELL TESTS: Minimum testing time is 1 hour
 Pump Bailer Air Flowing Artesian
 Yield gal/min Drawdown Drill stem/Pump depth Duration (hr)

463.3	102	160	4
		flow test done	
		8/25/2023	

Temperature 61 °F Lab analysis Yes By _____
 Water quality concerns? Yes (describe below) TDS amount 183 ppm
 From To Description Amount Units

--	--	--	--	--

(9) LOCATION OF WELL (legal description)
 County LINN Twp 12 S N/S Range 3 W E/W WM
 Sec 21 NE 1/4 of the NE 1/4 Tax Lot 100
 Tax Map Number _____ Lot _____
 Lat _____ " or 44.5158333 DMS or DD
 Long _____ " or -123.0530556 DMS or DD
 Street address of well Nearest address

Across from 31915 Seven Mile Ln. - Tangent, OR 97389

(10) STATIC WATER LEVEL

Existing Well / Pre-Alteration	Date	SWL(psi)	+ SWL(ft)
Completed Well	07-24-2023		20.2

 Flowing Artesian? Dry Hole?

WATER BEARING ZONES Depth water was first found 18

SWL Date	From	To	Est Flow	SWL(psi)	+ SWL(ft)
07-24-2023	18	42	MM		20.2
07-24-2023	68	320	540		20.2

(11) WELL LOG Ground Elevation _____

Material	From	To
Topsoil	0	2
Brown clay	2	14
Cemented gravel	14	18
Gravel dirty	18	42
Cemented clay sand w/some gravel	42	50
Cemented gravel small	50	52
Brown clay	52	68
Black sand & gravel cemented	68	76
Sandy gravel	76	97
Sandy clay	97	101
Sandy clay w/sand strips	101	120
Blue clay w/some sand strips	120	143
Cemented sand w/some gravel	143	147
Sandy clay w/strips of sands	147	180
Blue clay w/sand lenses	180	230
Blue clay w/significant sand strips and wood	230	316
Black sand	316	320

Construction Begin Date 07-11-2023 Begin Time 10 AM End Date 07-24-2023

(unbonded) Water Well Constructor Certification
 I certify that the work I performed on the construction, deepening, alteration, or abandonment of this well is in compliance with Oregon water supply well construction standards. Materials used and information reported above are true to the best of my knowledge and belief.

License Number 1411 Date 08-29-2023
 Signed _____

(bonded) Water Well Constructor Certification
 I accept responsibility for the construction, deepening, alteration, or abandonment work performed on this well during the construction dates reported above. All work performed during this time is in compliance with Oregon water supply well construction standards. This report is true to the best of my knowledge and belief.

License Number 1684 Date 08-29-2023
 Signed _____
 Contact Info (optional) jonesdrilling@hotmail.com

Step 1: Search for Well

Step 2: Create Well Map

Mark Well Point and Create Map:

Zoom in closer to the well location, if needed.
Mark the location of the well by either of these two methods:

A. Drawing on the map using the draw tool

Click on Icon and draw a point on the map

B. Type in the GPS Decimal Degrees:

GPS Latitude: 44.51583333
GPS Longitude: -123.053055556

Mark Point Clear Point

[Converter](#)

Results:

Latitude: 44.51583333
Longitude: -123.053055556


Complete the form:

Submitted by:

Address of Well:

City:

Special Notes:

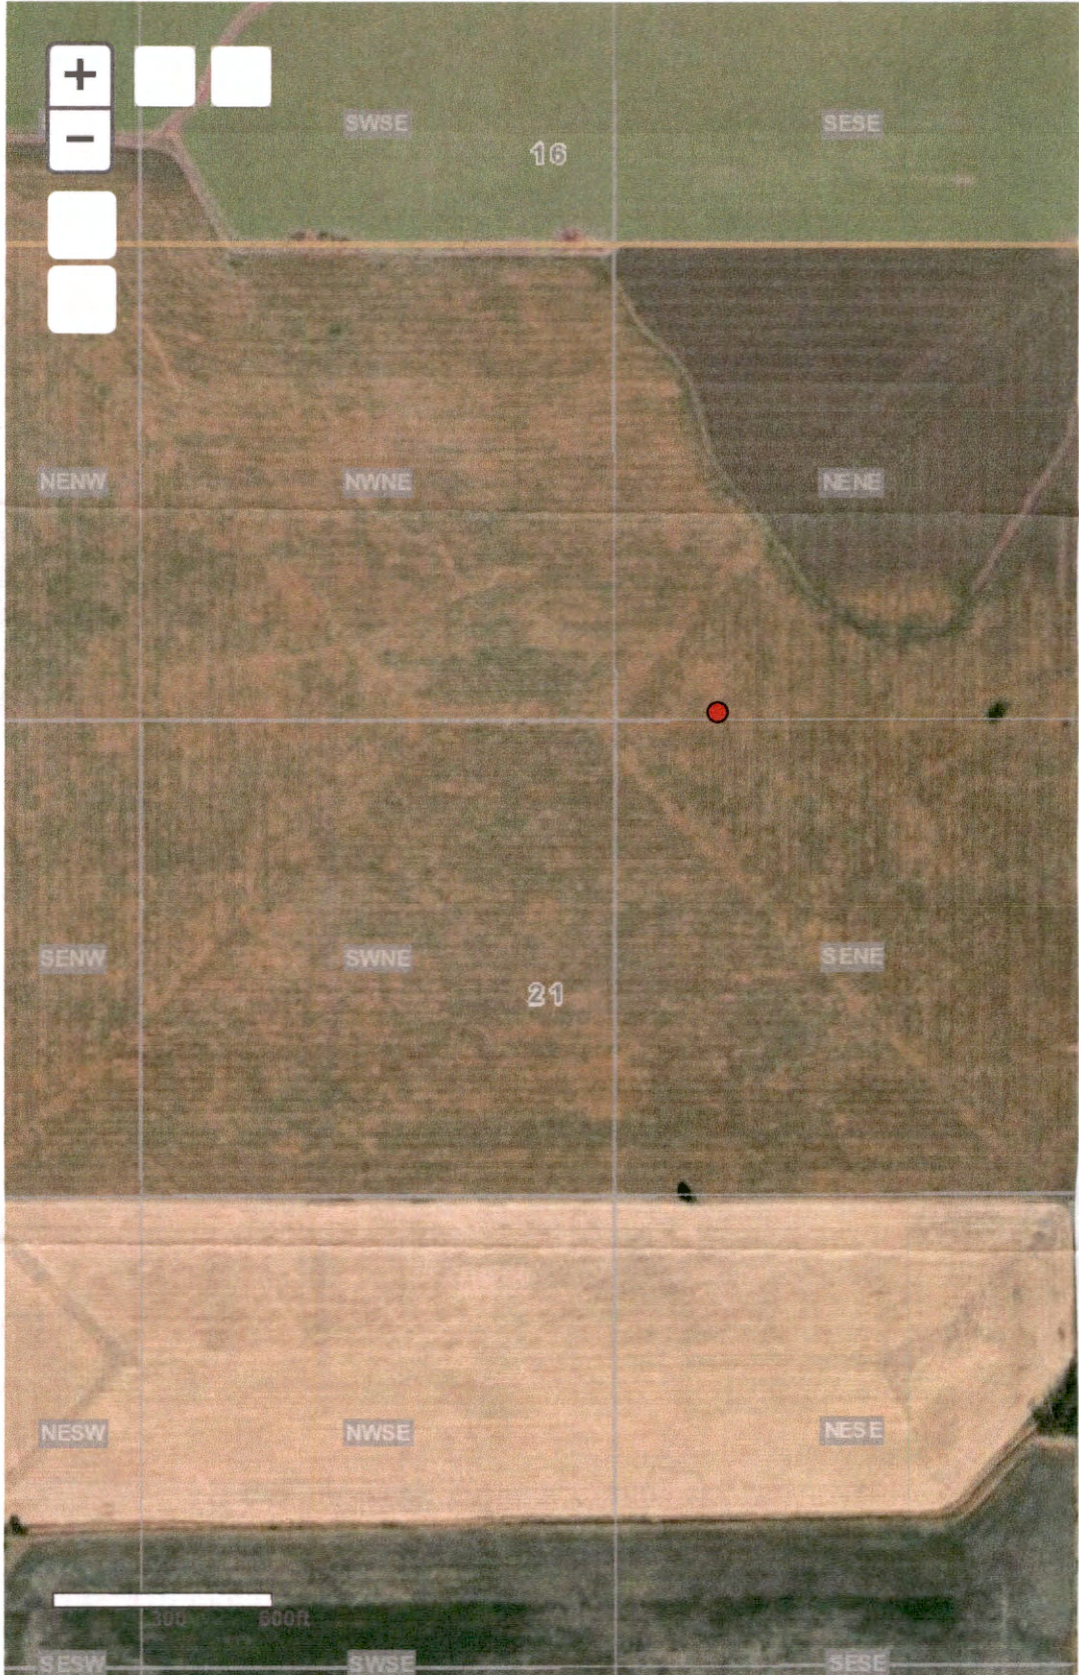

↑N L143508

RECEIVED
SEP 01 2023
OWRD