

STATE ENGINEER
Salem, Oregon

LINN
6437

Well Record

STATE WELL NO. 11/2W-10A
COUNTY Linn
APPLICATION NO. GR-3235

OWNER: Crawford Boyle

MAILING
ADDRESS: Box 52

LOCATION OF WELL: Owner's No. _____

CITY AND
STATE: Crabtree, Oregon

NE $\frac{1}{4}$ NE $\frac{1}{4}$ Sec. 10 T. 11 S. R. 2 W., W.M.

Bearing and distance from section or subdivision

corner 660' S. and 10' W. of N.E. corner
of Section 10


Altitude at well _____

TYPE OF WELL: drilled Date Constructed 1955

Depth drilled 40 Depth cased 40

CASING RECORD:

6 inch

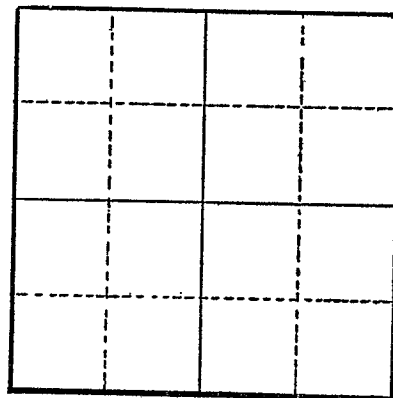

Section _____

FINISH:

Slot perforations from 36 to 40

AQUIFERS:

WATER LEVEL:

10 feet

PUMPING EQUIPMENT: Type Centrifugal H.P. 5
Capacity 150 G.P.M.

WELL TESTS:

Drawdown _____ ft. after _____ hours _____ G.P.M.

Drawdown _____ ft. after _____ hours _____ G.P.M.

USE OF WATER Irrigation Temp. _____ °F., 19____

SOURCE OF INFORMATION GR-3012

DRILLER or DIGGER Wm. Long, Route 3, Scio, Oregon

ADDITIONAL DATA:

Log _____ Water Level Measurements _____ Chemical Analysis _____ Aquifer Test _____

REMARKS: