

STATE ENGINEER
Salem, Oregon

LINN
6438

Well Record

STATE WELL NO. 11/2W - 10B
COUNTY LINN
APPLICATION NO. GR-1963

OWNER: Lawrence J. and Hazel Ritzinger

MAILING

ADDRESS: Rt. 3, Box 123

LOCATION OF WELL: Owner's No. No. 1


CITY AND

STATE: Scio, Oregon

NW $\frac{1}{4}$ NE $\frac{1}{4}$ Sec. 10 T. 11 M. E.
S., R. 2 W., W.M.

Bearing and distance from section or subdivision

corner 1254' S. & 1782' W.

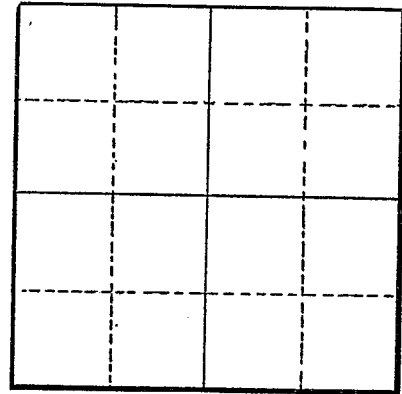

Section

Altitude at well

TYPE OF WELL: Drilled Date Constructed 1951

Depth drilled 25' Depth cased 25'

CASING RECORD:

8-inch

FINISH:

Perforations 21 to 25

AQUIFERS:

Not available

WATER LEVEL:

12-feet

PUMPING EQUIPMENT: Type Fairbanks Morse Centrifugal H.P. 20
Capacity 150 G.P.M.

WELL TESTS:

Drawdown ft. after hours G.P.M.

Drawdown ft. after hours G.P.M.

USE OF WATER Irrigation Temp. °F., 19....

SOURCE OF INFORMATION GR-1891

DRILLER or DIGGER Nicholas Klaus, Rt. 4, Albany, Oregon

ADDITIONAL DATA:

Log Water Level Measurements Chemical Analysis Aquifer Test

REMARKS: