

STATE ENGINEER
Salem, Oregon

LINN
6440

Well Record

STATE WELL NO. 11/2W-10H
COUNTY LINN
APPLICATION NO. GR-1964

OWNER: Lawrence J. & Hazel Ritzynger

MAILING ADDRESS: Rt. 3, Box 123


LOCATION OF WELL: Owner's No. #2

CITY AND STATE: Scio, Oregon

SE 1/4 NE 1/4 Sec. 10 T. 11 N. S. R. 2 E. W., W.M.

Bearing and distance from section or subdivision

corner 1386' S. & 594' W.

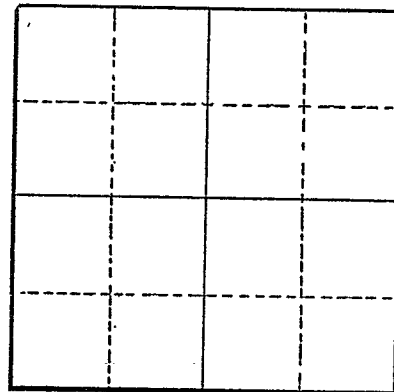

Section

Altitude at well

TYPE OF WELL: Drilled Date Constructed 1955

Depth drilled 30' Depth cased 30'

CASING RECORD:

8-inch

FINISH:

Perforations from 26 to 30

AQUIFERS:

Not available

WATER LEVEL:

14-feet

PUMPING EQUIPMENT: Type Pacific 2" Centrifugal H.P. 7
Capacity 100 G.P.M.

WELL TESTS:

Drawdown ft. after hours G.P.M.
Drawdown ft. after hours G.P.M.

USE OF WATER Irrigation Temp. °F., 19

SOURCE OF INFORMATION GR-1892

DRILLER or DIGGER Nicholas Klaus, Rt. 4, Albany, Oregon

ADDITIONAL DATA:

Log Water Level Measurements Chemical Analysis Aquifer Test

REMARKS: