

STATE ENGINEER
Salem, Oregon

LINN
6441

Well Record

STATE WELL NO. 11/2W-10N
COUNTY LINN
APPLICATION NO. GR-2400

OWNER: Ruey T. Blankenbaker


MAILING ADDRESS: Route 1, Box 304

LOCATION OF WELL: Owner's No.

CITY AND STATE: Albany, Oregon

SW 1/4 SW 1/4 Sec. 10 T. 11 S., R. 2 W., W.M.

Bearing and distance from section or subdivision corner 555' N. and 360' E.

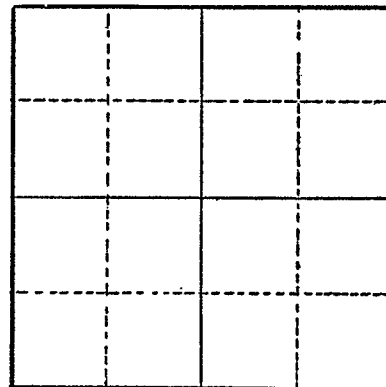

Section

Altitude at well

TYPE OF WELL: Drilled Date Constructed 1948

Depth drilled 21 Depth cased 21

CASING RECORD:

6-inch

FINISH:

Perforations from 18 to 21

AQUIFERS:

WATER LEVEL:

12-15-feet

PUMPING EQUIPMENT: Type G. E. Single Phase H.P. 5
Capacity 120 G.P.M.

WELL TESTS:

Drawdown ft. after hours G.P.M.
Drawdown ft. after hours G.P.M.

USE OF WATER Irrigation Temp. °F. 19

SOURCE OF INFORMATION GR-2281

DRILLER or DIGGER Mr. Blankenbaker

ADDITIONAL DATA:

Log Water Level Measurements Chemical Analysis Aquifer Test

REMARKS: