

STATE ENGINEER
Salem, Oregon

Well Record

STATE WELL NO. 11/2W-11E
COUNTY Linn
APPLICATION NO. GR-3804

OWNER: John C. Turner

MAILING

ADDRESS: Route 3, Box 920

LOCATION OF WELL: Owner's No. _____


CITY AND

STATE: Lebanon, Oregon

SE $\frac{1}{4}$ NW $\frac{1}{4}$ Sec. 11 T. 11 S., R. 2 W., W.M.

Bearing and distance from section or subdivision

corner S. 17° 20' E. 36.7 ch. from NW Cor. Sec. 11

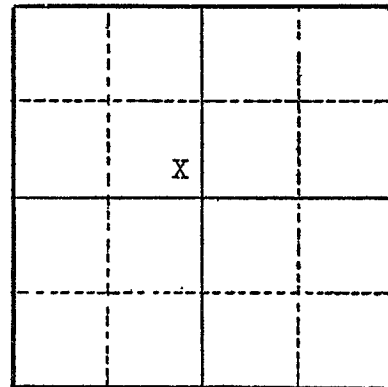

Altitude at well _____

TYPE OF WELL: Drilled Date Constructed 1947

Depth drilled 28 feet Depth cased 28 feet

Section 11

CASING RECORD:

8 inch steel casing set to 28 feet

FINISH:

Slot perforations from 18 to 28 feet

AQUIFERS:

WATER LEVEL:

14 feet below surface

PUMPING EQUIPMENT: Type Berkley 2 $\frac{1}{2}$ " centrifugal H.P. 7 $\frac{1}{2}$
Capacity 250 G.P.M.

WELL TESTS:

Drawdown _____ ft. after _____ hours _____ G.P.M.

Drawdown _____ ft. after _____ hours _____ G.P.M.

USE OF WATER Irrigation Temp. _____ °F., 19 _____

SOURCE OF INFORMATION Well Registration Statement

DRILLER or DIGGER _____

ADDITIONAL DATA:

Log _____ Water Level Measurements _____ Chemical Analysis _____ Aquifer Test _____

REMARKS: