

STATE ENGINEER
Salem, Oregon

LINN
6616
Well Record

STATE WELL NO. *11/2W-11F*
COUNTY *LINN*
APPLICATION NO. *GR-2985*

OWNER: *Walter E. and Myrtle A. Meyer*


MAILING ADDRESS: *Rt. 1, Box 309*

LOCATION OF WELL: Owner's No. _____

CITY AND STATE: *Albany, Oregon*

SE *1/4* NW *1/4* Sec. *11* T. *11* *N.* S. R. *2* *E.* W., W.M.

Bearing and distance from section or subdivision corner *1848' S. and 2772' W.*

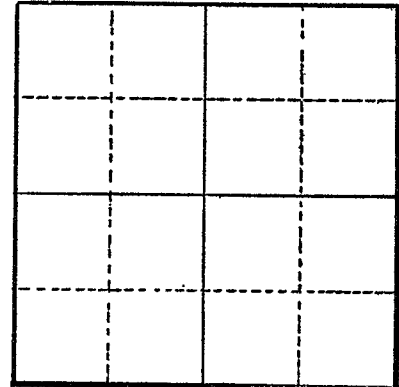

Section _____

Altitude at well _____

TYPE OF WELL: *Drilled* Date Constructed *1954*

Depth drilled *24* Depth cased *23' 6"*

CASING RECORD:

8-inch

FINISH:

Slot perforations from 13 to 23

AQUIFERS:

WATER LEVEL:

13-feet

PUMPING EQUIPMENT: Type *Fairbanks Morse Centrifugal* H.P. *10*
Capacity *200* G.P.M.

WELL TESTS:

Drawdown *22* ft. after _____ hours *Pumping 140* G.P.M.

Drawdown _____ ft. after _____ hours _____ G.P.M.

USE OF WATER *Irrigation* Temp. _____ °F. _____, 19

SOURCE OF INFORMATION *GR-2795*

DRILLER or DIGGER *Nicholas Klaus, Route 4, Albany, Oregon*

ADDITIONAL DATA:

Log _____ Water Level Measurements _____ Chemical Analysis _____ Aquifer Test _____

REMARKS: