

STATE ENGINEER
Salem, Oregon

LINN
6617

Well Record

STATE WELL NO. 11/2W-11H
COUNTY LINN
APPLICATION NO. GR-2989

OWNER: Gene Fallesen

MAILING
ADDRESS:

Box 28

LOCATION OF WELL: Owner's No.


CITY AND
STATE:

Crabtree, Oregon

SE 1/4 NE 1/4 Sec. 11 T. 11 S. R. 2 W., W.M.

Bearing and distance from section or subdivision

corner 1353' S. and 924' W.

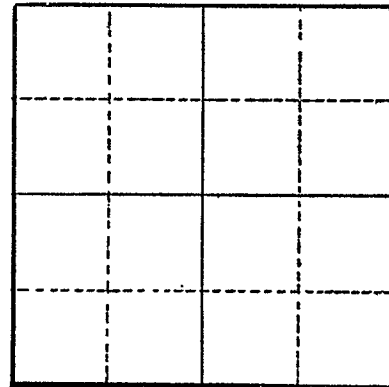

Altitude at well

TYPE OF WELL: Drilled Date Constructed 1953

Depth drilled 65 Depth cased 50

Section

CASING RECORD:

5-inch

FINISH:

AQUIFERS:

WATER LEVEL:

18-feet

PUMPING EQUIPMENT: Type Myers Centrifugal
Capacity G.P.M.

H.P. 2

WELL TESTS:

Drawdown ft. after hours G.P.M.

Drawdown ft. after hours G.P.M.

USE OF WATER Irrigation Temp. °F., 19

SOURCE OF INFORMATION GR-2798

DRILLER or DIGGER John Beard, Lebanon, Oregon

ADDITIONAL DATA:

Log Water Level Measurements Chemical Analysis Aquifer Test

REMARKS: