

LINN
6618

Well Record

OWNER: C. O. or Grace Pape


MAILING ADDRESS: Route 3, Box 92-C

LOCATION OF WELL: Owner's No.

CITY AND STATE: Lebanon, Oregon

NW ¼ SW ¼ Sec. 11 T. 11 S., R. 2 W., W.M.

Bearing and distance from section or subdivision corner 1716' N. 825' E. of the SW Corner of Section 11

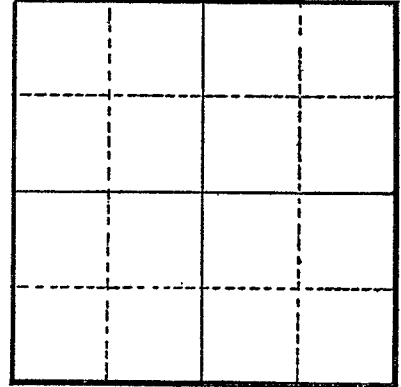

Section

Altitude at well

TYPE OF WELL: drilled Date Constructed 1940

Depth drilled 37' Depth cased 30'

CASING RECORD:

8 inch

FINISH:

Slot perforations from 20 to 30

AQUIFERS:

WATER LEVEL:

12'

PUMPING EQUIPMENT: Type Gardner Denver Cent. H.P.
Capacity G.P.M.

WELL TESTS:

Drawdown ft. after hours G.P.M.

Drawdown ft. after hours G.P.M.

USE OF WATER Irrigation Temp. °F., 19

SOURCE OF INFORMATION GR-3016

DRILLER or DIGGER Mr. Sloper, Independence, Oregon

ADDITIONAL DATA:

Log Water Level Measurements Chemical Analysis Aquifer Test

REMARKS: