

STATE ENGINEER
Salem, Oregon

LINN
6619

Well Record

STATE WELL NO. 11/2W-11Q
COUNTY Linn
APPLICATION NO. GR-3443

OWNER: Lawrence L. Etzel


MAILING ADDRESS: Route 3, Box 89

LOCATION OF WELL: Owner's No. Well #2

CITY AND STATE: Lebanon, Oregon

SW 1/4 SE 1/4 Sec. 11 T. 11 S., R. 2 W., W.M.

Bearing and distance from section or subdivision corner 660' N. and 2079' W.

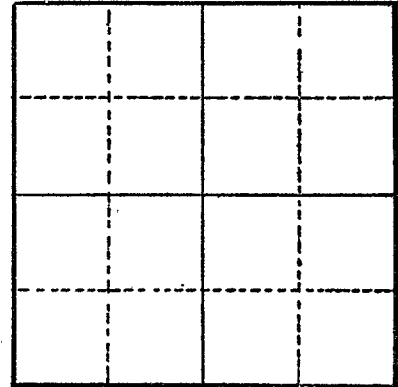

Section

Altitude at well

TYPE OF WELL: drilled Date Constructed 1951

Depth drilled 45' Depth cased 45'

CASING RECORD:

8"

FINISH:

slot perforations from 25 to 45

AQUIFERS:

WATER LEVEL:

3'

PUMPING EQUIPMENT: Type Western Turbine 3" H.P. 15
Capacity 300 G.P.M.

WELL TESTS:

Drawdown 40 ft. after hours pumping 105 G.P.M.
Drawdown ft. after hours G.P.M.

USE OF WATER Irrigation Temp. °F., 19

SOURCE OF INFORMATION GR-3184

DRILLER or DIGGER Nicholas Klaus Route 4, Albany, Oregon

ADDITIONAL DATA:

Log Water Level Measurements Chemical Analysis Aquifer Test

REMARKS: