

STATE ENGINEER
Salem, Oregon

LIN N
6620

Well Record

STATE WELL NO. 11/2W-11R
COUNTY Linn
APPLICATION NO. GR-3444

OWNER: Lawrence L. Etzel


MAILING ADDRESS: Route 3, Box 89

LOCATION OF WELL: Owner's No. Well #1

CITY AND STATE: Lebanon, Oregon

SE 1/4 SE 1/4 Sec. 11 T. 11 N. 2 E. S., R. W., W.M.

Bearing and distance from section or subdivision corner 1023' S. and 1155' W.

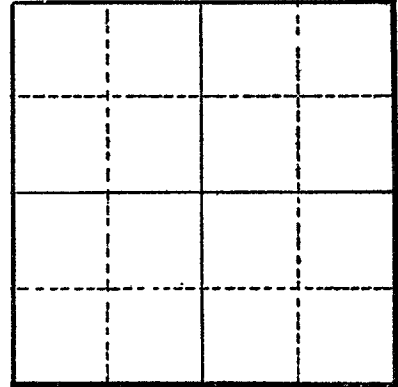

Section

Altitude at well

TYPE OF WELL: drilled Date Constructed 1948

Depth drilled 60' Depth cased 60'

CASING RECORD:

8"

FINISH:

slot perforations from 40 to 60

AQUIFERS:

WATER LEVEL:

8'

PUMPING EQUIPMENT: Type Berkeley Turbine 2" H.P. 5
Capacity 100 G.P.M.

WELL TESTS:

Drawdown 30 ft. after hours pumping 60 G.P.M.
Drawdown ft. after hours G.P.M.

USE OF WATER Irrigation Temp. °F., 19

SOURCE OF INFORMATION GR-3185

DRILLER or DIGGER Bill Hamilton, Albany, Oregon

ADDITIONAL DATA:

Log Water Level Measurements Chemical Analysis Aquifer Test

REMARKS: