

STATE ENGINEER
Salem, Oregon

Well Record

STATE WELL NO. 11/2W-14B(1)
COUNTY Linn
APPLICATION NO. GR-235

OWNER: Allen and Lucille Wollam

MAILING
ADDRESS: Rt. 3, Box 86

LOCATION OF WELL: Owner's No. 1

CITY AND
STATE: Lebanon, Oregon

NW 1/4 NE 1/4 Sec. 14 T. 11 N. S. R. 2 E. W.M.


Bearing and distance from section or subdivision

corner S. 26° 30' E. 50 links from NW cor. NE 1/4

Altitude at well 285 ft. Interpolated

TYPE OF WELL: dug Date Constructed 1941

Depth drilled 16 ft. Depth cased

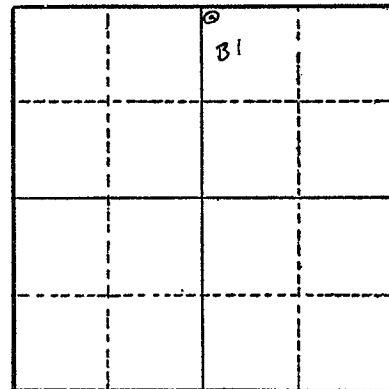

Section 14

CASING RECORD: 4' x 6' cribbed with 1" boards. Intake pipe extends from
0 to 14 ft.

FINISH: no record

AQUIFERS: no record

WATER LEVEL: 6 ft. below land surface

PUMPING EQUIPMENT: Type 2 1/2" centrifugal H.P. 15
Capacity 500 G.P.M.

WELL TESTS:
Drawdown 12 ft. after hours pumping 500 G.P.M.
Drawdown ft. after hours G.P.M.

USE OF WATER irrigation 19 acres Temp. °F. 19

SOURCE OF INFORMATION Reg. St. GR-

DRILLER or DIGGER Frank Betzer; Albany, Oregon

ADDITIONAL DATA:

Log Water Level Measurements Chemical Analysis Aquifer Test

REMARKS: