

STATE ENGINEER
Salem, Oregon

LINN
6684

Well Record

STATE WELL NO. 11/2W-15-F
COUNTY LINN
APPLICATION NO. GR-2986

OWNER: Raymond L. and Elinor Meyer


MAILING ADDRESS: Route 1, Box 310

LOCATION OF WELL: Owner's No. #1

CITY AND STATE: Albany, Oregon

SE 1/4 NW 1/4 Sec. 15 T. 11 S., R. 2 W., W.M.

Bearing and distance from section or subdivision corner 2772' N. and 1000' E.

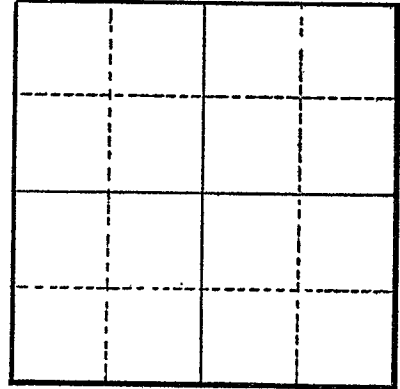

Section

Altitude at well

TYPE OF WELL: drilled Date Constructed 1949

Depth drilled 27 Depth cased 26' 9"

CASING RECORD:

10-inch

FINISH:

Slot perforations from 17 to 26

AQUIFERS:

WATER LEVEL:

8-feet

PUMPING EQUIPMENT: Type Centrifugal H.P. 10
Capacity 250 G.P.M.

WELL TESTS:

Drawdown 9 ft. after hours Pumping 600 G.P.M.
Drawdown ft. after hours G.P.M.

USE OF WATER Irrigation Temp. °F., 19.....

SOURCE OF INFORMATION GR-2796

DRILLER or DIGGER Bill Hamilton Drilling Co., 838 E. third ave., Albany, Oregon

ADDITIONAL DATA:

Log Water Level Measurements Chemical Analysis Aquifer Test

REMARKS: