

STATE ENGINEER
Salem, Oregon

LINN
6685

Well Record

STATE WELL NO. 11/2W-15F
COUNTY LINN
APPLICATION NO. GR-2367

OWNER: Mrs. W. H. Faulkner

MAILING ADDRESS:

Rt. 1, Box 308


LOCATION OF WELL: Owner's No. #1

CITY AND STATE:

Albany, Oregon

SE 1/4 NW 1/4 Sec. 15 T. 11 N. S. R. 2 W., W.M.

Bearing and distance from section or subdivision corner 1386' S. & 1386' E.

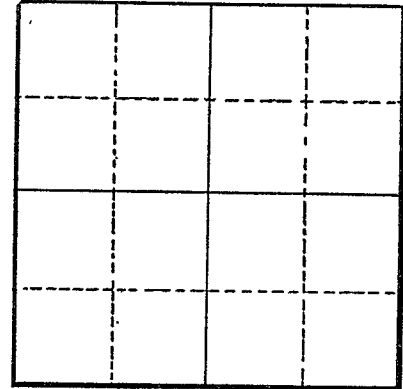

Section

Altitude at well

TYPE OF WELL: Drilled Date Constructed 1948

Depth drilled 27 Depth cased 20

CASING RECORD:

10-inch

FINISH:

Perforations from 13' to 20'

AQUIFERS:

Gravel, clay and sand

WATER LEVEL:

8-feet

PUMPING EQUIPMENT: Type Fairbanks Morse Centrifugal
Capacity G.P.M.

H.P. 19

WELL TESTS:

Drawdown ft. after hours G.P.M.
Drawdown ft. after hours G.P.M.

USE OF WATER Irrigation Temp. °F., 19

SOURCE OF INFORMATION GR-2248

DRILLER or DIGGER Bill Hamilton Well Drilling Co., 838 E. 3rd. Ave., Albany, Oregon

ADDITIONAL DATA:

Log Water Level Measurements Chemical Analysis Aquifer Test

REMARKS:

Sandy Loam
Gravel and yellow clay
Sand and gravel